

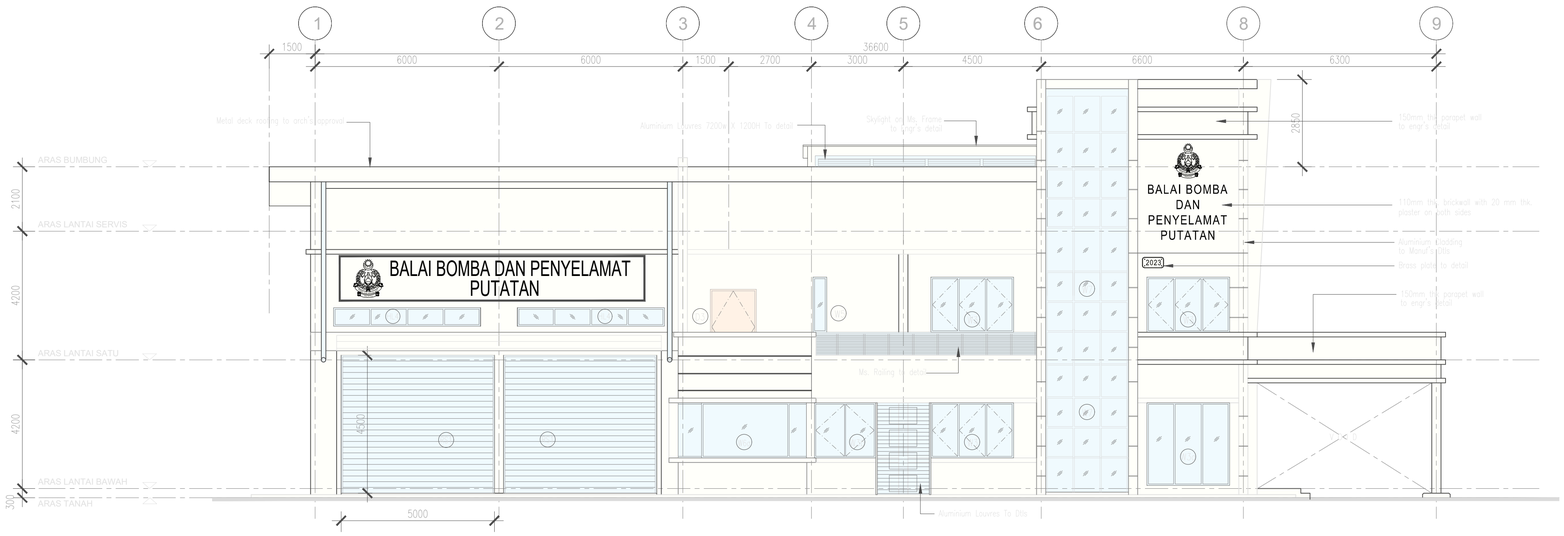



PANDANGAN HADAPAN
SKALA 1:100

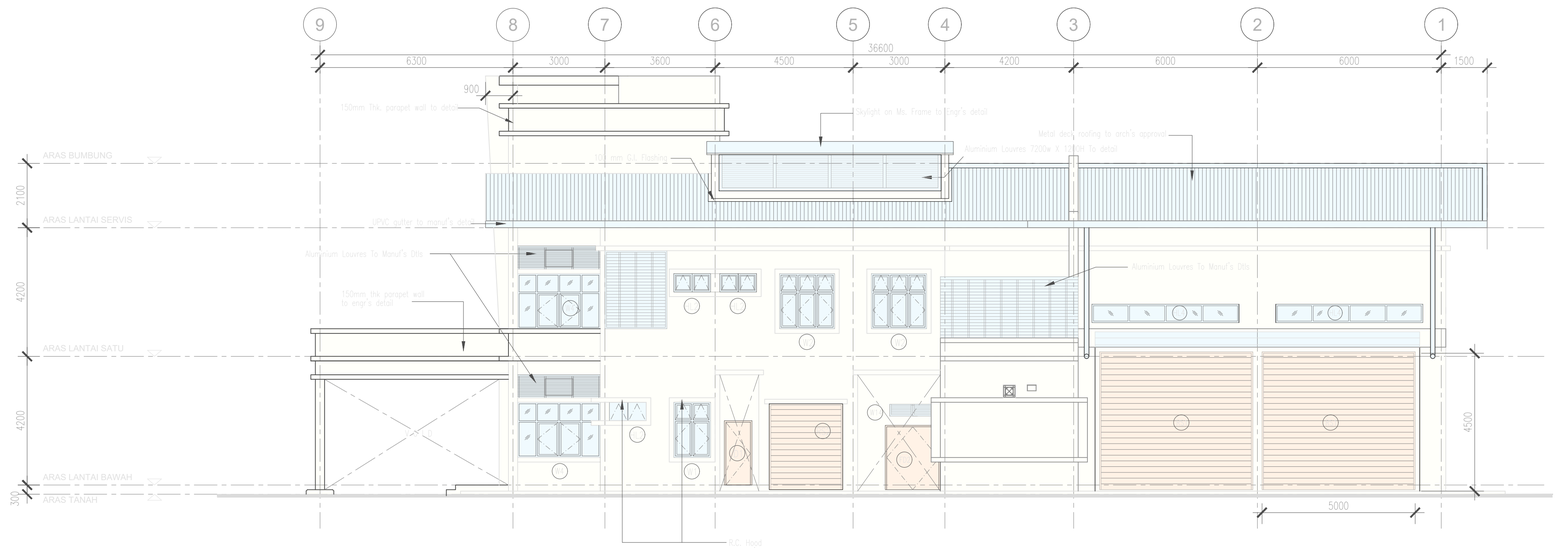

PANDANGAN BELAKANG
SKALA 1:100

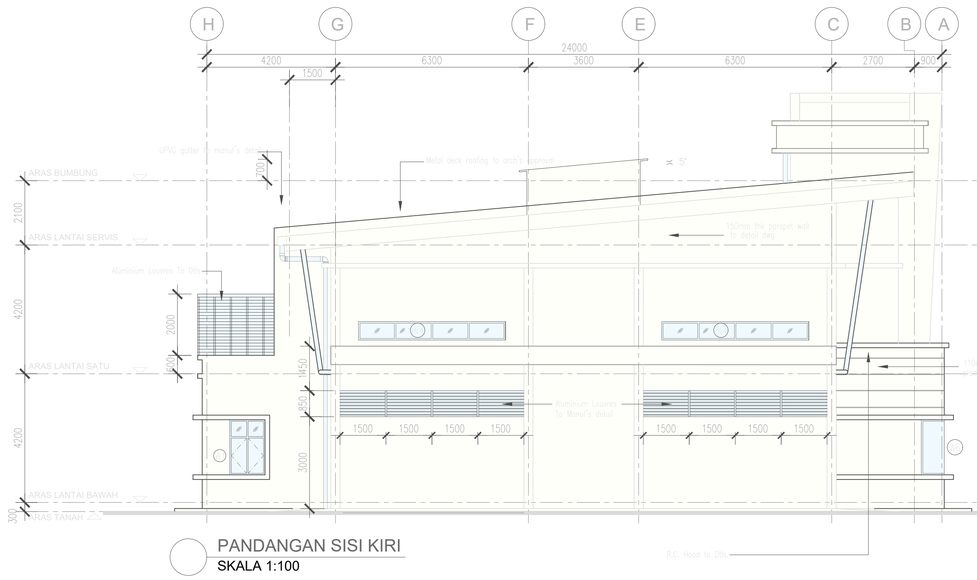

PANDANGAN SISI KIRI
SKALA 1:100

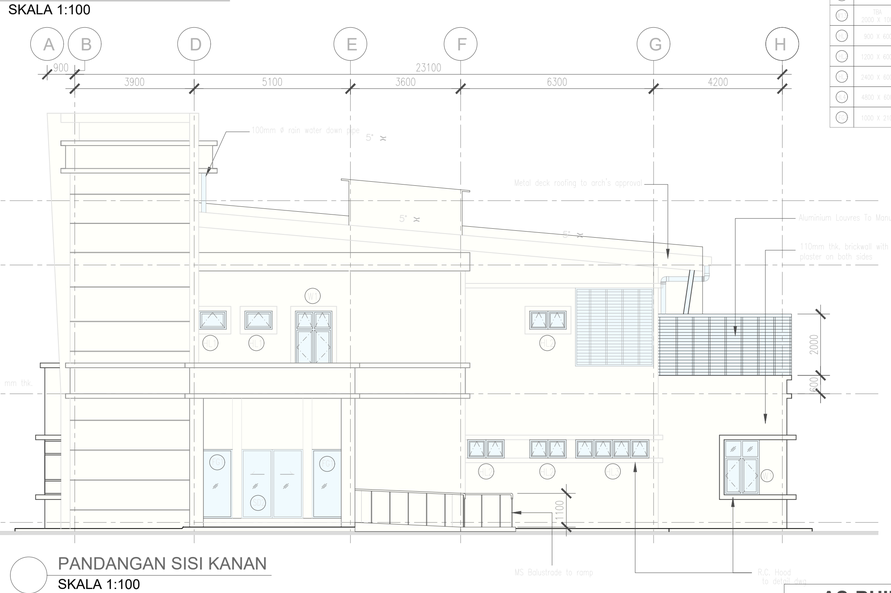

PANDANGAN SISI KANAN
SKALA 1:100

SCHEDULE OF FLOOR AREA, NATURAL LIGHTING AND VENTILATION

DESCRIPTION	FLOOR AREA (M SQ.)	OPENING REQUIRED (10%) M SQ.	OPENING PROVIDED M SQ.	OPENING PROVIDED %	REMARKS
PELAN LANTAI ARAS BAWAH					
RUANG SERIBU 1 / RUANG SERIBU 2	29.84	KAWASAN TERBUKA			
RUANG KOR / RUANG TIDUR 1 / RUANG PEMERIKSA	58.71	5.87	7.09	16.4	
RUANG KOKOK PERAWAT	10.76	10.76	4.03	10.05	
TELEKOM OFFICER	10.05	5.42	5.42	10.79	
RUANG KAWALAN	7.5	7.5	KAWASAN MEKANIKAL		
RUANG PENGUDARA	14.4	14.4	KAWASAN MEKANIKAL		
RUANG MESS & PANTRI	22.68	2.26	4.20	18.52	
RUANG SERIBU WANITA	9.67	9.67	2.42	25.03	
TANGGA WANITA	4	0.4	2.42	60.5	
TANGGA LELAKI	4.4	0.44	2.42	55.00	
RUANG BAWAH TANGGA	4.41	KAWASAN MEKANIKAL			
RUANG SERIBU	19.4	19.4	17.00	87.63	
RUANG	7.2	7.2	KAWASAN TERBUKA		
KELUAR 1 TANGGA 2	57.12	KAWASAN TERBUKA			
RUANG SERIBU	14.15	KAWASAN MEKANIKAL			
TELEFON	1.12				
TELEFON	1.12				
KESELURUHAN (Grd)	572.63				

DESCRIPTION	FLOOR AREA (M SQ.)	OPENING REQUIRED (10%) M SQ.	OPENING PROVIDED M SQ.	OPENING PROVIDED %	REMARKS
PELAN LANTAI ARAS SATU					
RUANG MESYUARAT / KELAS	40.15	4.01	9.47	23.59	
RUANG KOKOK DAPUR	10.76	10.76	4.03	10.05	
RUANG UNIT PELAWAT	20.24	3.22	2.42	11.96	
RUANG PENGURUSAN PEGAWAI	19.2	5.63	2.42	12.6	
RUANG SERIBU	9.67	9.67	2.42	25.03	
RUANG PENGURUSAN LELAKI	20.25	2.25	3.61	17.8	
TANGGA LELAKI	4.4	0.44	2.42	55.00	
RUANG SERIBU	7.26	7.26	1.21	16.66	
RUANG TANGGA	3.92	KAWASAN TERBUKA			
TANGGA	7.4	7.4	4.80	64.9	
KELUAR 1	9.87	0.99	7.80	79.05	
TELEFON	1.12	KAWASAN TERBUKA			
KELUAR 2	45.43	KAWASAN TERBUKA			
TELEFON	1.12				
TELEFON	1.12				
KESELURUHAN (1st)	267.37				

KESELURUHAN (Grd)= 572.63
KESELURUHAN (1st)= 267.37
Total Area (Bdsk)= 840 m.sq.

DOOR SCHEDULE

	No. Width x Height	DESCRIPTION
D1	750 x 2200	METAL FRAME TIMBER SOLID DOOR
D2	900 x 2200	METAL FRAME PLYWOOD FLUSH DOOR
D3	1200 x 2200	METAL FRAME TIMBER SOLID DOOR
D4	1200 x 2200	METAL FRAME TIMBER SOLID DOOR
D5	800 x 2200	METAL FRAME PLYWOOD FLUSH DOOR C/W SWINGING DOOR
D6	1200 x 2200	ALUMN FRAME GLASS SLIDING DOOR WITH FIXED GLASS PANEL
D7	4000 x 4000	ROLLER SHUTTER TO MANUF'S DETAIL
D8	1200 x 2200	ROLLER SHUTTER TO MANUF'S DETAIL
D9	1100 x 2200	FIRE RATED DOOR
D10	1100 x 2200	1HR FIRE RATED DOOR
D11	900 x 2200	2HR FIRE RATED DOOR
D12	800 x 2200	2HR FIRE RATED DOOR

WINDOW SCHEDULE

	No. Width x Height	DESCRIPTION
W1	2250 X 1800	CURVED CASTED ALUMN. FRAME 6mm THK. TINTED GLASS PANEL TO MANUF'S DTL
W2	1800 X 1800	CURVED CASTED ALUMN. FRAME 6mm THK. TINTED GLASS PANEL TO MANUF'S DTL
W3	3150 X 1800	CURVED CASTED ALUMN. FRAME 6mm THK. TINTED GLASS PANEL TO MANUF'S DTL
W4	2400 X 1800	CURVED CASTED ALUMN. FRAME 6mm THK. TINTED GLASS PANEL TO MANUF'S DTL
W5	2850 X 1800	CURVED CASTED ALUMN. FRAME 6mm THK. TINTED GLASS PANEL TO MANUF'S DTL
W6	1500 X 1800	CURVED CASTED ALUMN. FRAME 6mm THK. TINTED GLASS PANEL TO MANUF'S DTL
W7	450 X 1800	CURVED CASTED ALUMN. FRAME 6mm THK. TINTED GLASS PANEL TO MANUF'S DTL
W8	900 X 1800	CURVED CASTED ALUMN. FRAME 6mm THK. TINTED GLASS PANEL TO MANUF'S DTL
W9	1800 X 1200	CURVED CASTED ALUMN. FRAME 6mm THK. TINTED GLASS PANEL TO MANUF'S DTL
W10	1200 X 1800	CURVED CASTED ALUMN. FRAME 6mm THK. TINTED GLASS PANEL TO MANUF'S DTL
W11	600 X 1200	CURVED CASTED ALUMN. FRAME 6mm THK. TINTED GLASS PANEL TO MANUF'S DTL
W12	2250 X 1200	CURVED CASTED ALUMN. FRAME 6mm THK. TINTED GLASS PANEL TO MANUF'S DTL
W13	2400 X 1200	CURVED CASTED ALUMN. FRAME 6mm THK. TINTED GLASS PANEL TO MANUF'S DTL
W14	3150 X 1200	CURVED CASTED ALUMN. FRAME SLIDING WINDOW 6mm THK. TINTED GLASS PANEL TO MANUF'S DTL
W15	900 X 1200	CURVED CASTED ALUMN. FRAME 6mm THK. TINTED GLASS PANEL TO MANUF'S DTL
W16	600 X 600	CURVED CASTED ALUMN. FRAME 6mm THK. TINTED GLASS PANEL TO MANUF'S DTL
W17	1500 X 600	CURVED CASTED ALUMN. FRAME 6mm THK. TINTED GLASS PANEL TO MANUF'S DTL
W18	2400 X 600	CURVED CASTED ALUMN. FRAME 6mm THK. TINTED GLASS PANEL TO MANUF'S DTL
W19	1500 X 2100	CURVED CASTED ALUMN. FRAME 6mm THK. TINTED GLASS PANEL TO MANUF'S DTL

NOTES
- The contractor shall verified all dimensions on site prior to commencement of work.
- Do not scale drawing, use written dimensions or grid lines only.
- This drawing to be read in conjunction with the specification and conditions of contract.
- This drawing to be read in conjunction with others related M&E and C&S drawings.
- This drawing and design are copyright and no portion maybe reproduced without the permission from "ALASIM OMAR ARCHITECT"

FOR AUTHORITY USE

No.	Description	

KERAJAAN MALAYSIA

TAJUK PROJEK :

CADANGAN PEMBINAAN PROJEK BALAI BOMBA & KUARTERS PUTATAN DI ATAS SEBAHAGIAN LOT N.T 213059771, JALAN SAILAN IMBAAN PUTATAN, DAERAH PUTATAN, SABAH

PEMILIK PROJEK :

KEMENTERIAN PERUMAHAN DAN KERAJAAN TEMPATAN
Bahagian Pembangunan & Pelaksanaan Projek,
Aras 5, No. 51, Persiaran Perdana,
Presint 4, 62100 Putrajaya, Malaysia

PEMILIK BANGUNAN :

BAHAGIAN PEMBANGUNAN, IBU PEJABAT,
JABATAN BOMBA DAN PENYELAMAT, MALAYSIA
Tingkat 4, Lebuh Wawasan, Presint 7,
62250 Putrajaya, Malaysia.

"SAYA MEMPERAKUI BAHAWA BUTIRAN-BUTIRAN DI DALAM PELAN-PELAN INI ADALAH MENURUT KEHENDAK-KEHENDAK UNDANG-UNDANG KECIL BANGUNAN SERAGAM 1984 DAN SAYA SETUJU TERIMA TANGGUNGJAWAB PENUH DENGAN SEWAJARNYA".

Ar. Datu Alasim Datu Omar
PROFESSIONAL ARCHITECT
LAM REGISTRATION NUMBER : A/D 17

ALASIM OMAR ARCHITECT
F-27-1, ROYAL PLAZA PUTATAN
KM 11.2, JALAN PUTATAN
88200, KOTA KINABALU, SABAH
E : alasim.architect@gmail.com
T : +6 088 760 752 F: +6 088 761 752

DRAWING INFORMATION

SCALE : 1:100
DATE : JANUARY 2024
REVISION : 0

DRAWING TITLE

BALAI BOMBA
-PANDANGAN HADAPAN
-PANDANGAN BELAKANG
-PANDANGAN SISI KIRI
-PANDANGAN SISI KANAN

AS-BUILT DRAWING

200413/ASBUILT/004/REV.0