

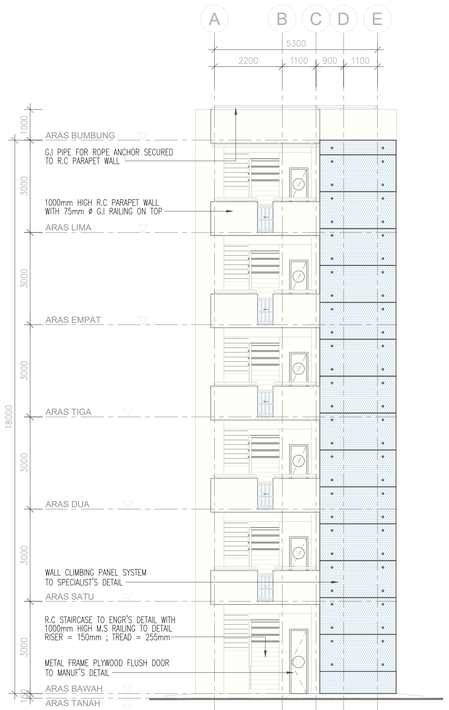



5 PANDANGAN HADAPAN
SKALA 1:100

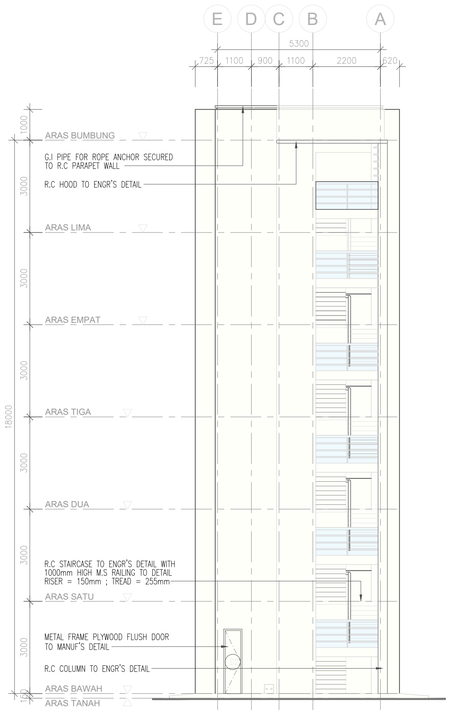


6 PANDANGAN BELAKANG
SKALA 1:100

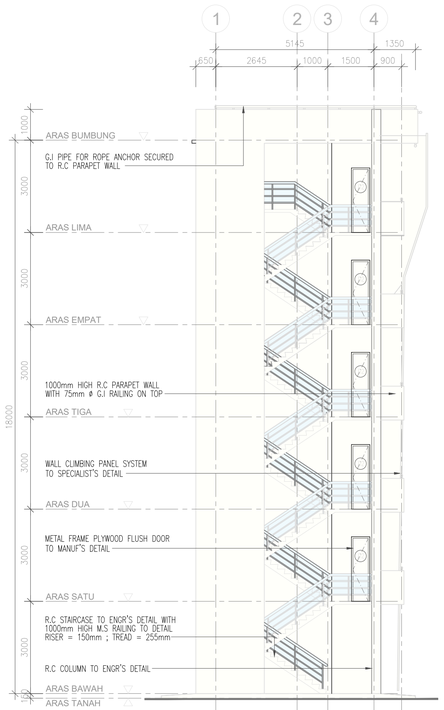


7 PANDANGAN SISI KIRI
SKALA 1:100

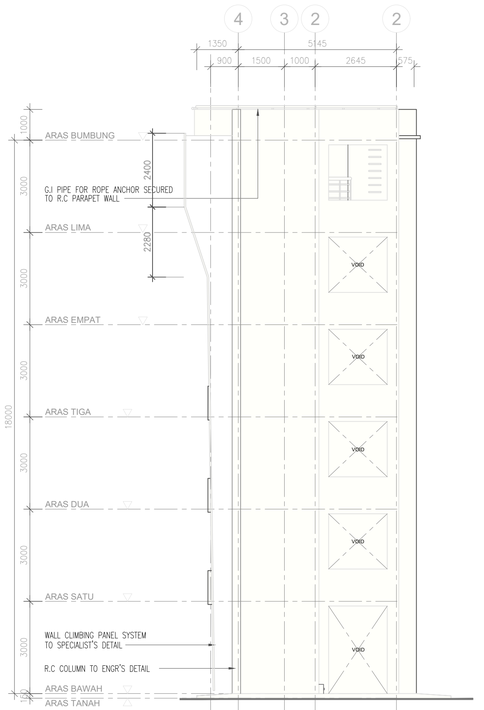


8 PANDANGAN SISI KANAN
SKALA 1:100

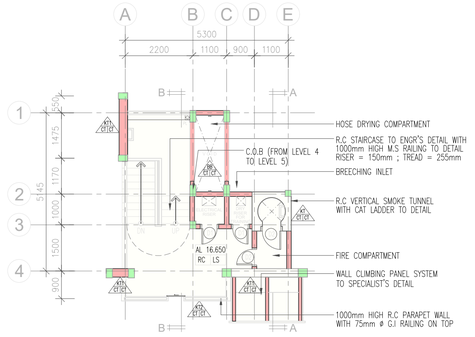


3 PELAN ARAS LIMA
SKALA 1:100

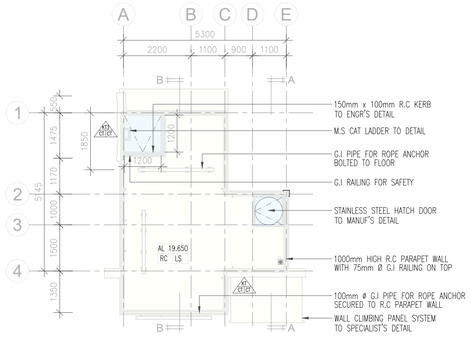


4 PELAN ARAS BUMBUNG
SKALA 1:100

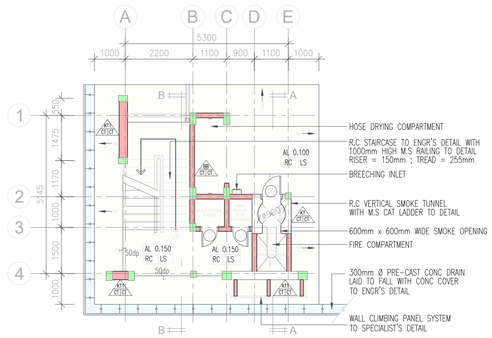


1 PELAN ARAS BAWAH
SKALA 1:100

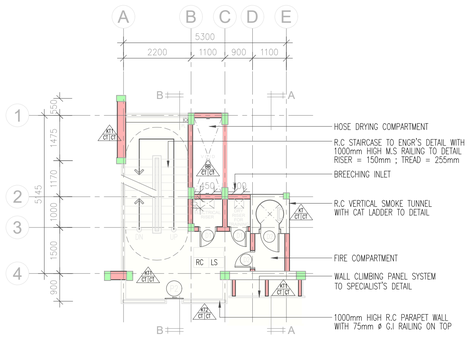

2 PELAN ARAS SATU HINGGA EMPAT
SKALA 1:100

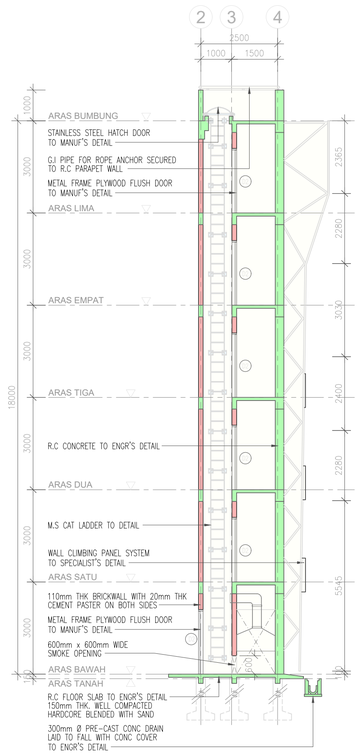

9 KERATAN A - A
SKALA 1:100

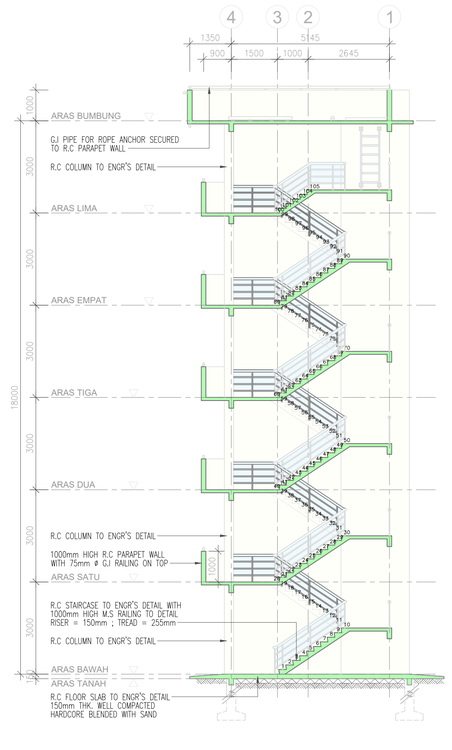

10 KERATAN B - B
SKALA 1:100

AS-BUILT DRAWING

- The contractor shall verified all dimensions on site prior to commencement of work.
- Do not scale drawing, use written dimensions or grid lines only.
- This drawing to be read in conjunction with the specification and conditions of contract.
- This drawing to be read in conjunction with others related M&E and C&S drawings.
- This drawing and design are copyright and no portion thereof reproduced without the permission from "ALASIM OMAR ARCHITECT"

FOR AUTHORITY USE

No.	Description	

KERAJAAN MALAYSIA

TAJUK PROJEK :

CADANGAN PEMBINAAN PROJEK BALAI BOMBA & KUARTERS PUTATAN DI ATAS SEBAHAGIAN LOT N.T 213059771, JALAN SAILAN IMBAAN PUTATAN, DAERAH PUTATAN, SABAH

PEMILIK PROJEK :

KEMENTERIAN PERUMAHAN DAN KERAJAAN TEMPATAN
Bahagian Pembangunan & Pelaksanaan Projek,
Aras 5, No. 51, Persiaran Perdana,
Presint 4, 62100 Putrajaya, Malaysia

PEMILIK BANGUNAN :

BAHAGIAN PEMBANGUNAN, IBU PEJABAT,
JABATAN BOMBA DAN PENYELAMAT, MALAYSIA
Tingkat 4, Lebuh Wawasan, Presint 7,
62250 Putrajaya, Malaysia.

"SAYA MEMPERAKUI BAHAWA BUTIRAN-BUTIRAN DI DALAM PELAN-PELAN INI ADALAH MENURUT KEHENDAK-KEHENDAK UNDANG-UNDANG KECIL BANGUNAN SERAGAM 1984 DAN SAYA SETUJU TERIMA TANGGUNGJAWAB PENUH DENGAN SEWAJARNYA".

Ar. Datu Alasim Datu Omar
PROFESSIONAL ARCHITECT
LAM REGISTRATION NUMBER : A/D 17

ALASIM OMAR ARCHITECT
F-27-1, ROYAL PLAZA PUTATAN
KM 11.2, JALAN PUTATAN
88200, KOTA KINABALU, SABAH
E : alasim.architect@gmail.com
T : +6 088 760 752 F: +6 088 761 752

DRAWING INFORMATION	DRAWING TITLE
SCALE : 1:100 DATE : JANUARY 2024 REVISION : 0	MENARA LATIHAN -PELAN LANTAI ARAS BAWAH -PELAN ARAS 1-4 -PELAN ARAS LIMA -PELAN BUMBUNG -KERATAN A-A & KERATAN B-B -PANDANGAN HADAPAN & PANDANGAN BELAKANG -PANDANGAN BELAKANG -PANDANGAN KIRI & PANDANGAN KANAN

200413/ASBUILT/008/REV.08