

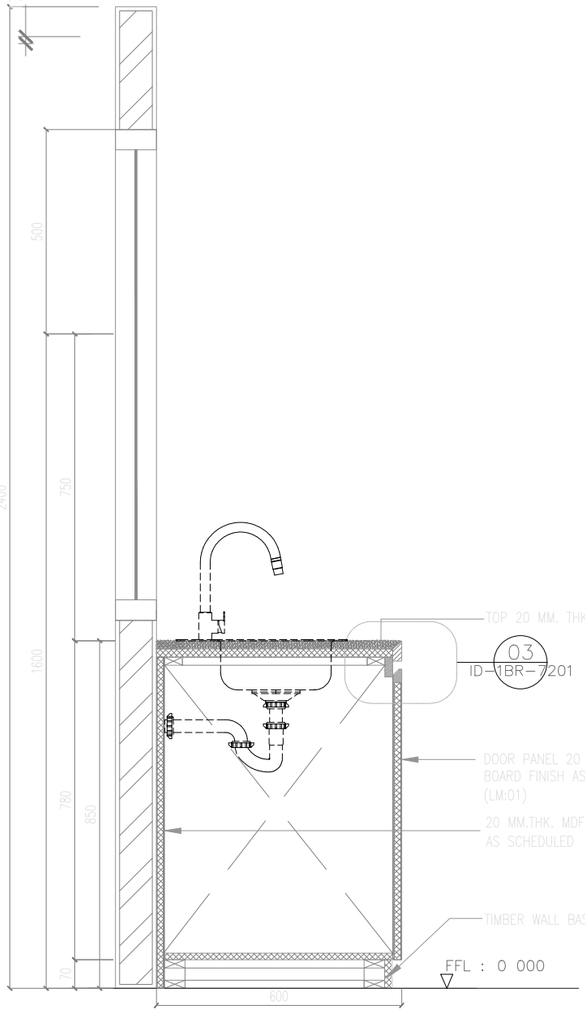



1 KERATAN 1-1
SKALA 1:15

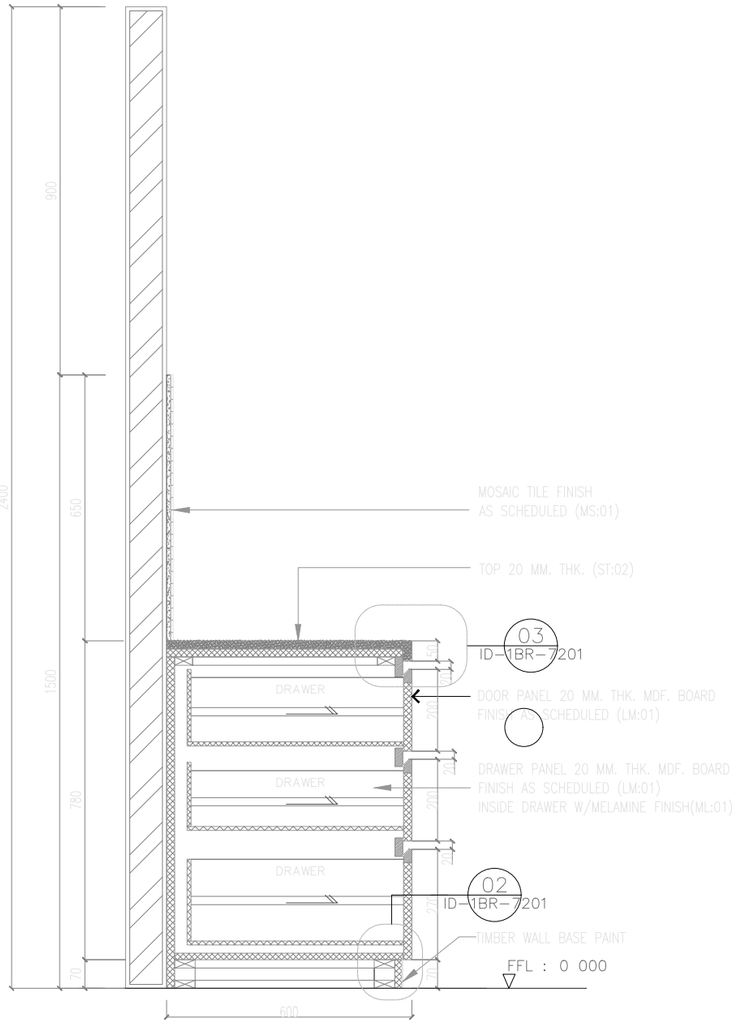


2 KERATAN 2-2
SKALA 1:15

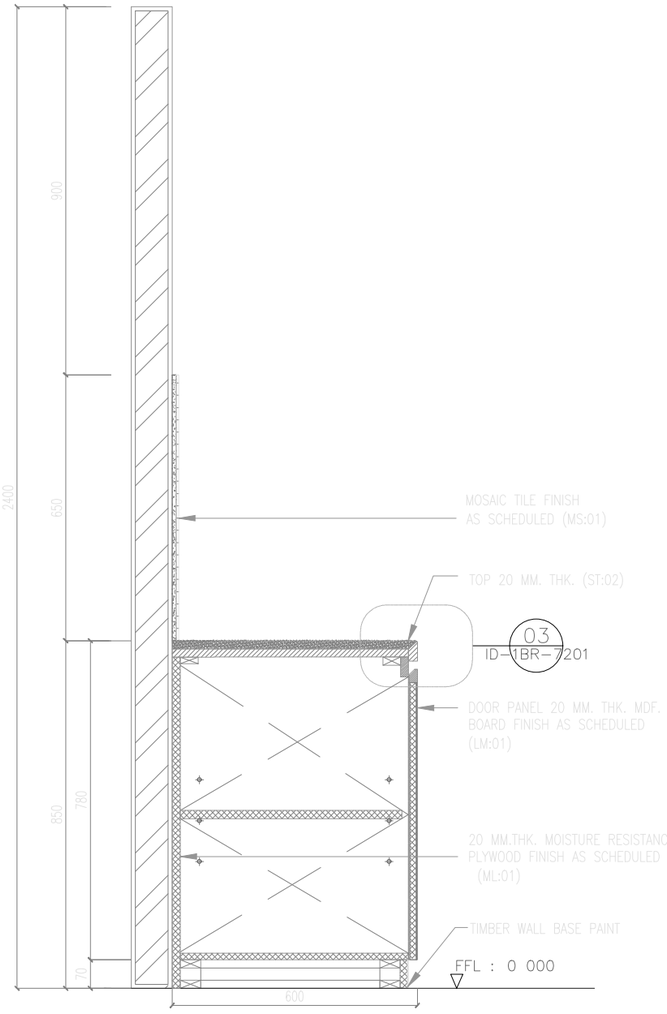


3 KERATAN 3-3
SKALA 1:15

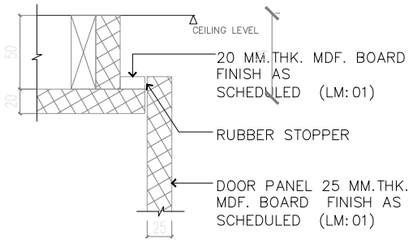


01 TYPICAL JOINERY DETAIL 1
SKALA 1:5

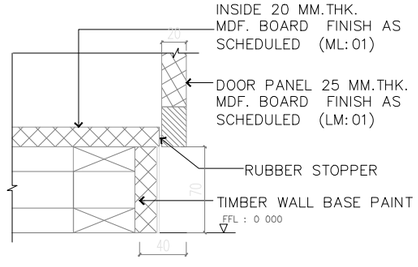

02 TYPICAL JOINERY DETAIL 2
SKALA 1:5

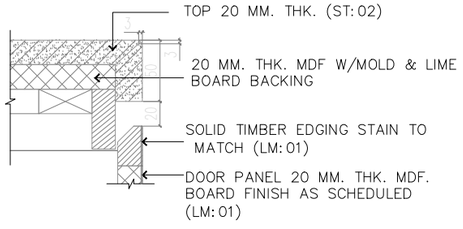

03 TYPICAL JOINERY DETAIL 3
SKALA 1:5

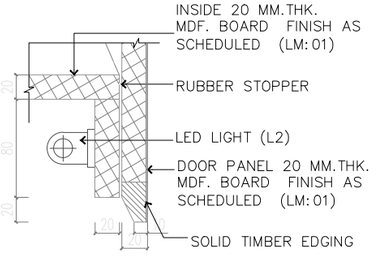

04 TYPICAL JOINERY DETAIL 4
SKALA 1:5

AS-BUILT DRAWING

Pemaju :
KEMENTERIAN PERUMAHAN DAN KERAJAAN TEMPATAN

Pemilik :
JABATAN BOMBA DAN PENYELAMAT MALAYSIA

Tajuk Projek:
CADANGAN PEMBINAAN PROJEK BALAI BOMBA & KUARTERS PUTATAN DI ATAS SEBAHAGIAN LOT N.T 213059771, JALAN SAILAN IMBAAN PUTATAN, DAERAH PUTATAN, SABAH

Tajuk Komponen:
KUARTERS
(DAPUR UNIT KELAS F)

Tajuk Lukisan:
KERATAN 1
KERATAN 2
KERATAN 3
TYPICAL JOINERY DETAIL 1
TYPICAL JOINERY DETAIL 2
TYPICAL JOINERY DETAIL 3
TYPICAL JOINERY DETAIL 4

ARCHITECT
ALASIM OMAR ARCHITECT
F-27-1, ROYAL PLAZA PUTATAN
KM 11.2, JALAN PUTATAN
88200, KOTA KINABALU, SABAH
E : alasim.architect@gmail.com
T : +6 088 760 752
F: +6 088 761 752

DWG INFO
Scale : As Shown
Date : JANUARY 2024
Drawing Number : Revision 0

DWG TITLE

Sketch	DP Sub	JPBM	Construction
Prelim	BP Sub	Contract	As-Built

200413/ASBUILT/026(1)/REV.0