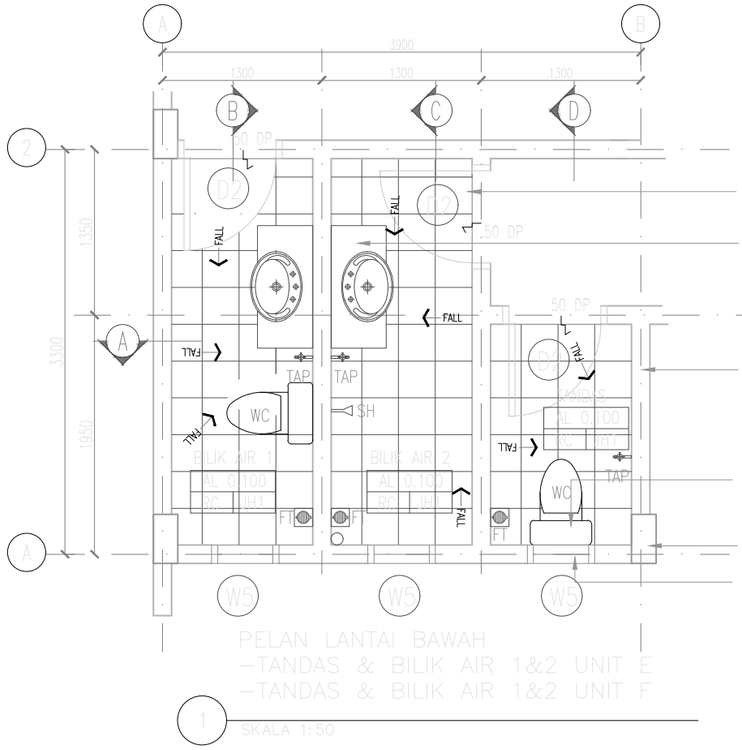


PELAN LANTAI BAWAH
–TANDAS & BILIK AIR 1&2 UNIT E
–TANDAS & BILIK AIR 1&2 UNIT F

1 SKALA 1:50

DOOR REFER TO DOOR SCHEDULE


CONCRETE COUNTER TOP C/W 200mm X 200mm GLAZED CERAMIC TILES FINISHED

110mm THK. BWK WITH 20mm THK. CEMENT PLASTER C/W 300mm X 300mm CERAMIC WALL TILES UP TO 1500mm HIGHT

WATER CLOSET AND FLUSH VALVE WALL HUNG WASHDOWN WATER CLOSET


R.C COLUMN TO ENGR'S DETAIL

WINDOW REFER TOWINDOW SCHEDULE

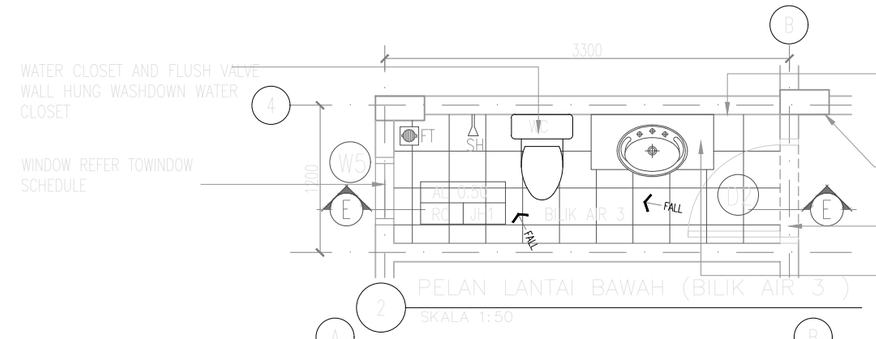


PELAN LANTAI BAWAH (BILIK AIR 3)

2 SKALA 1:50

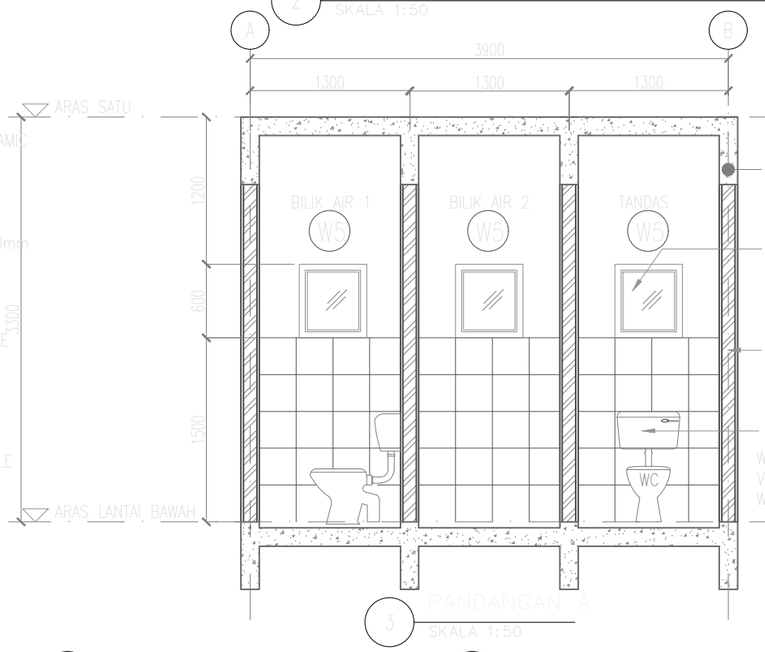


PANDANGAN A

3 SKALA 1:50

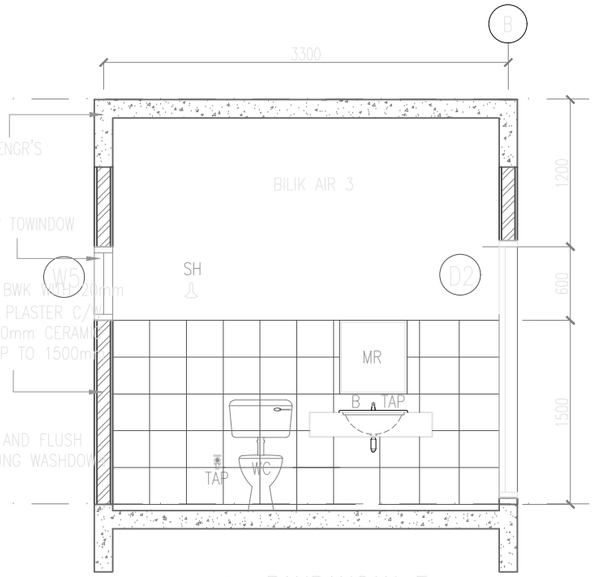


PANDANGAN E

7 SKALA 1:50

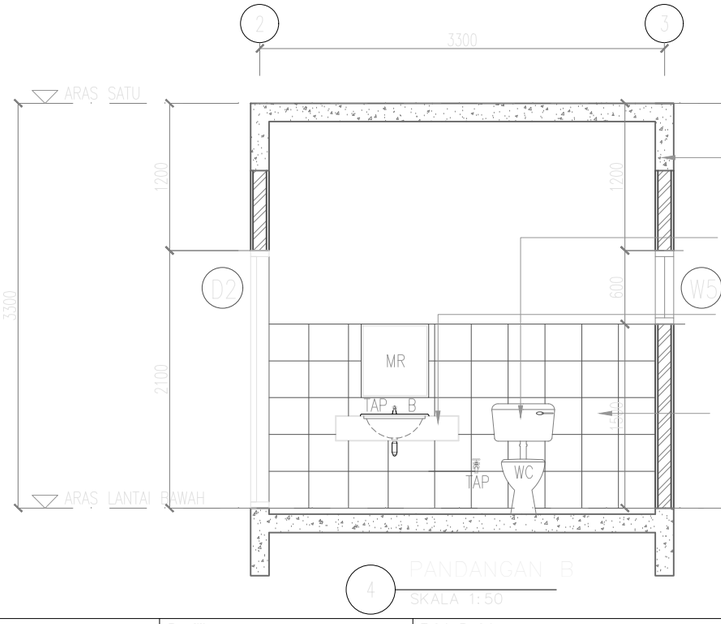


PANDANGAN B

4 SKALA 1:50

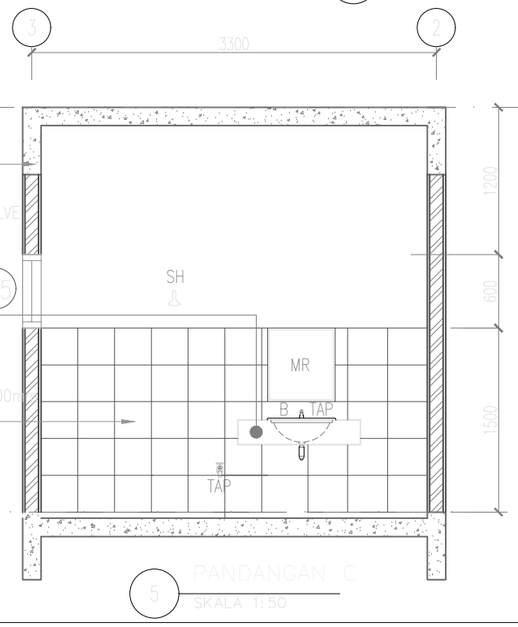

PANDANGAN C

5 SKALA 1:50

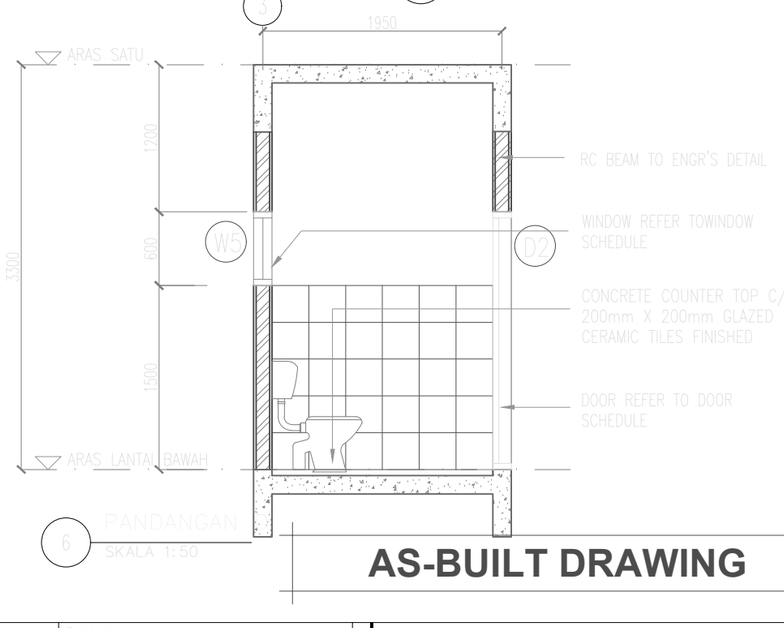

PANDANGAN F

6 SKALA 1:50

AS-BUILT DRAWING

Pemaju :

KEMENTERIAN PERUMAHAN DAN KERAJAAN TEMPATAN

Pemilik :

JABATAN BOMBA DAN PENYELAMAT MALAYSIA

Tajuk Projek:

CADANGAN PEMBINAAN PROJEK BALAI BOMBA & KUARTERS PUTATAN DI ATAS SEBAHAGIAN LOT N.T 213059771, JALAN SAILAN IMBAAN PUTATAN, DAERAH PUTATAN, SABAH

Tajuk Komponen:

KUARTERS
(TANDAS & BILIK AIR UNIT E & F)

Tajuk Lukisan:

PELAN LANTAI BAWAH
PANDANGAN A
PANDANGAN B
PANDANGAN C
PANDANGAN D
PANDANGAN E

ARCHITECT
ALASIM OMAR ARCHITECT
F-27-1, ROYAL PLAZA PUTATAN
KM 11.2, JALAN PUTATAN
88200, KOTA KINABALU, SABAH
E : alasim.architect@gmail.com
T : +6 088 760 752
F: +6 088 761 752

DWG INFO
Scale : As Shown
Date : JANUARY 2024
Drawing Number : Revision 0

DWG TITLE

Sketch	DP Sub	JPBM	Construction
Prelim	BP Sub	Contract	As-Built

200413/ASBUILT/031/REV.0