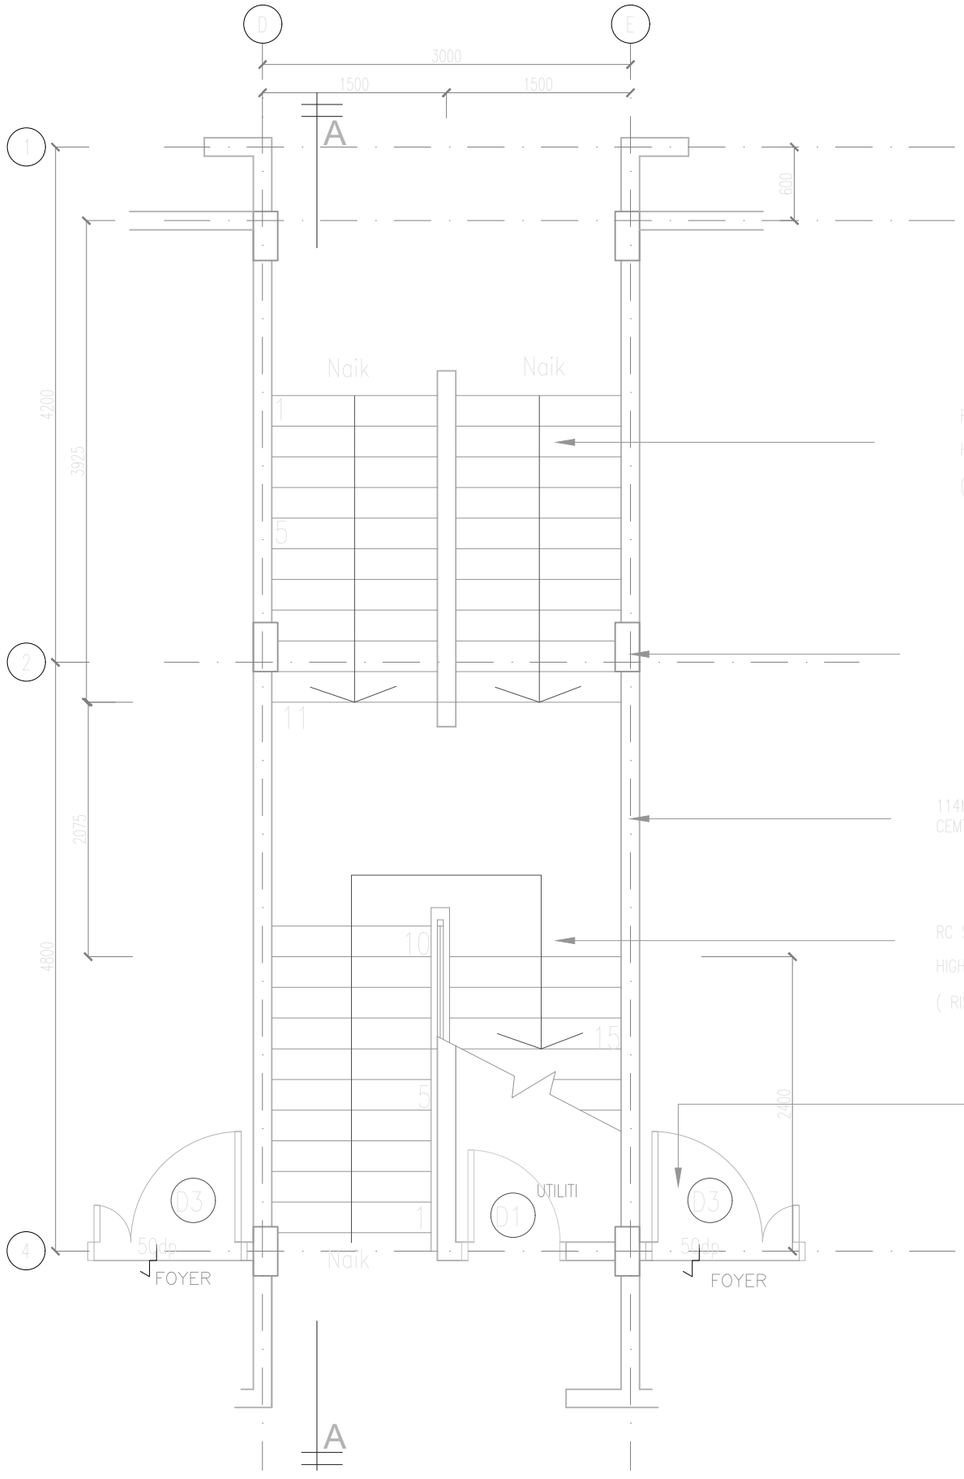


RC STAIRCASE TO ENGR'S DETAIL WITH 1000MM HIGH STAINLESS STEEL RAILING TO DETAIL (RISERS = 150MM, TREADS = 225MM)


R.C COLUM TO ENGR'S DETAIL

114MM THK BRICKWALL WITH 20MM THK. CEMT. PLASTER ON BOTH SIDES.

RC STAIRCASE TO ENGR'S DETAIL WITH 1000MM HIGH STAINLESS STEEL RAILING TO DETAIL (RISERS = 150MM, TREADS = 225MM)

DOOR REFER TO DOOR SCHEDULE

1 PELAN LANTAI BAWAH
SKALA 1:50

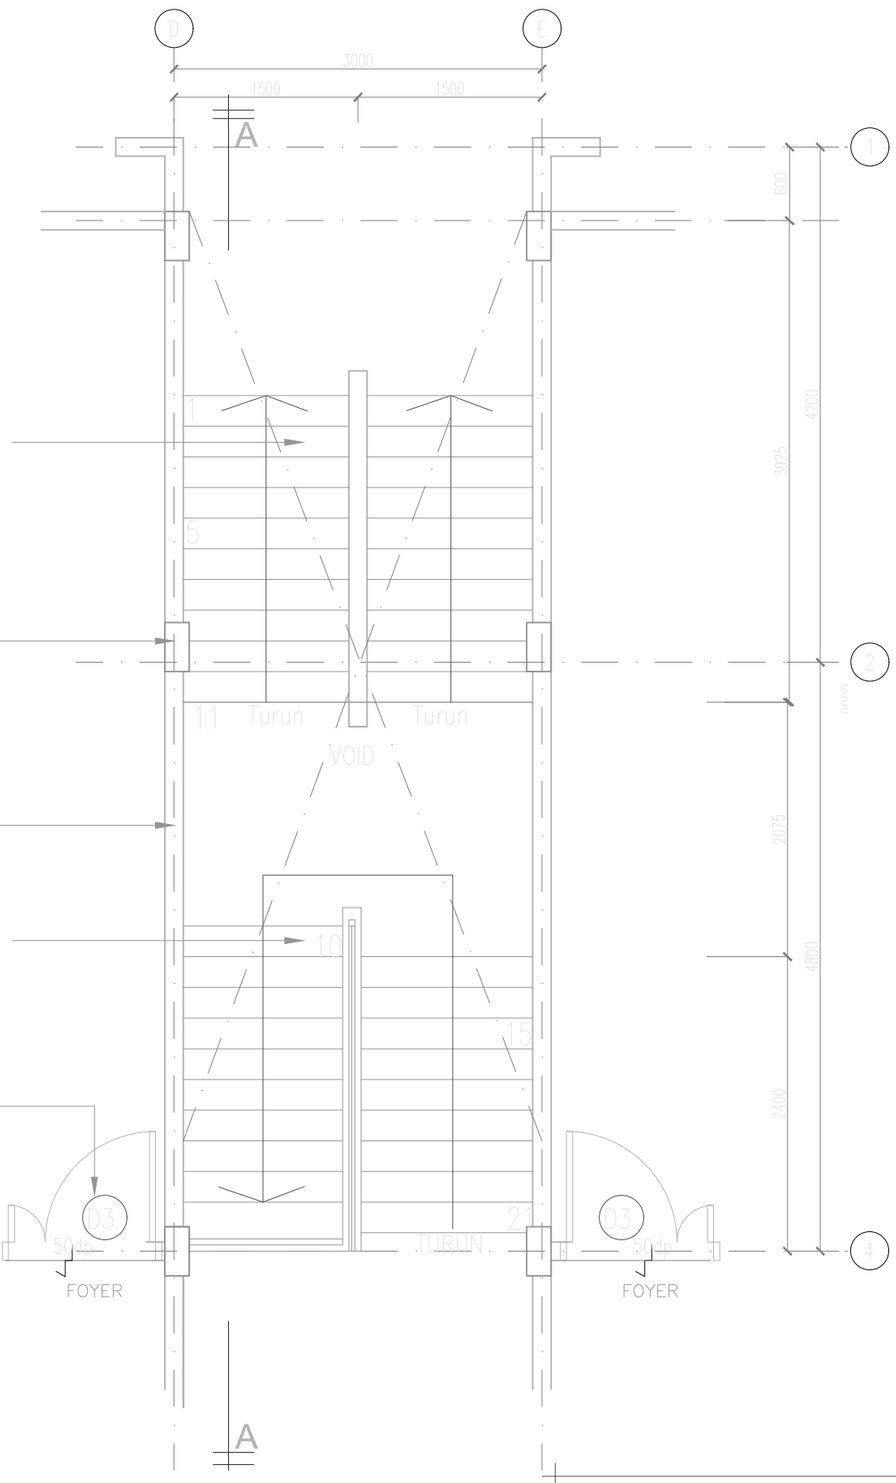

2 PELAN ARAS SATU
SKALA 1:50

AS-BUILT DRAWING

Pemaju :

KEMENTERIAN PERUMAHAN DAN KERAJAAN TEMPATAN

Pemilik :

JABATAN BOMBA DAN PENYELAMAT MALAYSIA

Tajuk Projek:

CADANGAN PEMBINAAN PROJEK BALAI BOMBA & KUARTERS PUTATAN DI ATAS SEBAHAGIAN LOT N.T 213059771, JALAN SAILAN IMBAAN PUTATAN, DAERAH PUTATAN, SABAH

Tajuk Komponen:

KUARTERS
(TANGGA)

Tajuk Lukisan:

PELAN LANTAI BAWAH
PELAN ARAS SATU

ARCHITECT
ALASIM OMAR ARCHITECT
F-27-1, ROYAL PLAZA PUTATAN
KM 11.2, JALAN PUTATAN
88200, KOTA KINABALU, SABAH
E : alasim.architect@gmail.com
T : +6 088 760 752
F: +6 088 761 752

Scale : As Shown
Date : JANUARY 2024

Sketch	DP Sub	JPBM	Construction
Prelim	BP Sub	Contract	As-Built

Drawing Number : Revision 0

DWG NO.

200413/ASBUILT/032/REV.0