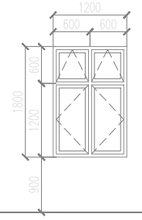
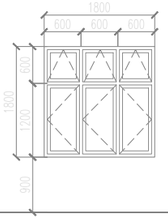
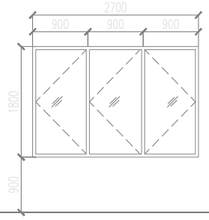
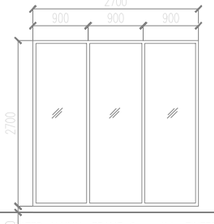
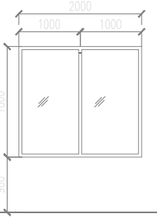
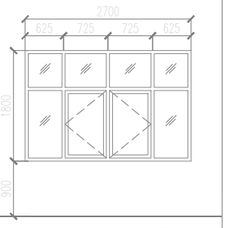
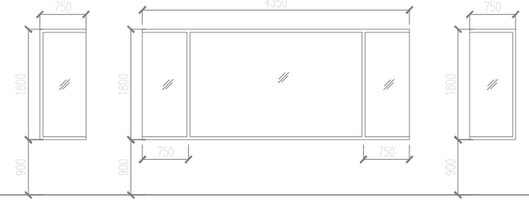
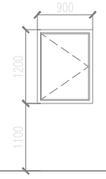
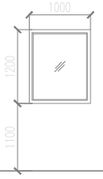
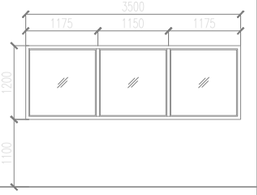
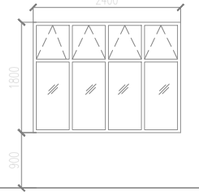
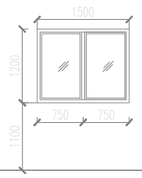
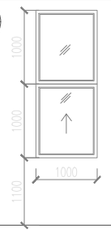
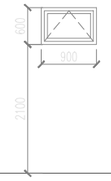
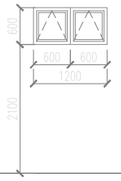
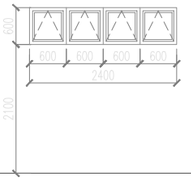
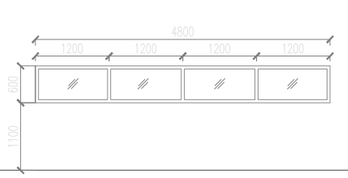
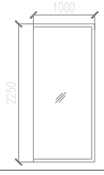
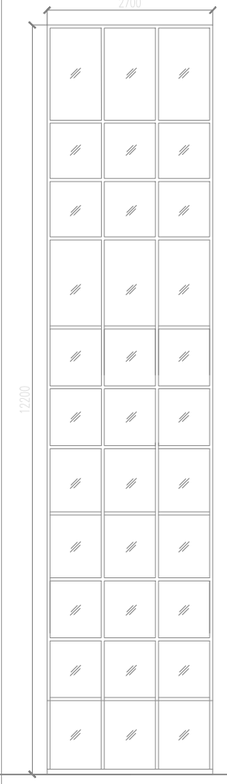
TYPE		W1	W2	W3	W3A	W3B	W4
							
SPECIFICATION		POWDER COATED ALUMN. FRAME 6mm thk. TINTED GLASS CASEMENT WINDOW WITH TOP HUNG GLASS WINDOW ABOVE TO MANUF'S DTL.	POWDER COATED ALUMN. FRAME 6mm thk. TINTED GLASS CASEMENT WINDOW WITH TOP HUNG GLASS WINDOW ABOVE TO MANUF'S DTL.	POWDER COATED ALUMN. FRAME 6mm thk. TINTED GLASS CASEMENT WINDOW TO MANUF'S DTL.	POWDER COATED ALUMN. FRAME 6mm thk. TINTED FIXED GLASS PANEL TO MANUF'S DTL.	POWDER COATED ALUMN. FRAME 6mm thk. TINTED FIXED GLASS PANEL TO MANUF'S DTL.	POWDER COATED ALUMN. FRAME 6mm thk. TINTED GLASS CASEMENT WINDOW WITH 6mm thk. TINTED FIXED GLASS PANEL ABOVE AND BOTH SIDES TO MANUF'S DTL.
SIZE	HEIGHT	1800	1800	1800	2700	1800	1800
	WIDTH	1200	1800	2700	2700	2000	2700
LOCATION LOCATION	ARAS 1 (BLOK UTAMA)	BILIK PERSEDIAAN WANITA BILIK MESS & PANTRI	–	PEJABAT OPERASI	RUANG PAMERAN	PEJABAT OPERASI	BILIK KETUA BALAI
	ARAS 2 (BLOK UTAMA)	BILIK UNIT PILI BOMBA	BILIK PERSEDIAAN LELAKI	SURAU	–	–	BILIK PERSEDIAAN PENYELIA
FLOOR LEVELS	ARAS 1	4	–	2	1	1	1
	ARAS 2	1	2	1	–	–	1
	RUMAH PAM	–	2	–	–	–	–
TOTAL NOS		5	4	3	1	1	2

TYPE		W5	W6	W8	W9	W10	W11
							
SPECIFICATION		POWDER COATED ALUMN. FRAME 6mm thk. TINTED FIXED GLASS PANEL TO MANUF'S DTL.	POWDER COATED ALUMN. FRAME 6mm thk. TINTED FIXED GLASS PANEL TO MANUF'S DTL.	POWDER COATED ALUMN. FRAME 6mm thk. GLASS CASEMENT WINDOW TO MANUF'S DTL.	POWDER COATED ALUMN. FRAME 6mm thk. TINTED FIXED GLASS PANEL TO MANUF'S DTL.	POWDER COATED ALUMN. FRAME 6mm thk. TINTED FIXED GLASS PANEL TO MANUF'S DTL.	POWDER COATED ALUMN. FRAME W/ 6 MM FIXED GLASS PANEL WITH TOP HUNG GLASS WINDOW ABOVE TO MANUF'S DTL.
SIZE	HEIGHT	1800	1800	1200	1200	1200	1800
	WIDTH	750 X 4350 X 750		900	1000	3500	2400
LOCATION LOCATION	ARAS 1 (BLOK UTAMA)	450 BILIK KETUA BALAI	BILIK KAWALAN	–	PEJABAT OPERASI	PEJABAT OPERASI	
	ARAS 2 (BLOK UTAMA)	BILIK MESYUARAT/KULIAH, BILIK UNIT PILI BOMBA BILIK GYM	–	RUANG JEMURAN	–	–	BILIK SUKAN GYM
FLOOR LEVELS	ARAS 1	3	1	–	1	1	–
	ARAS 2	10	–	1	–	–	1
TOTAL NOS		13	1	1	1	1	1

TYPE		W12	W13	HL1	HL2	HL3	HL4	FG1
								
SPECIFICATION		POWDER COATED ALUMN FRAME SLIDING WINDOW TO MANUF'S DTL.	POWDER COATED ALUMN FRAME SLIDING WINDOW AND FIXED TOP HUNG WINDOW TO MANUF'S DTL.	POWDER COATED ALUMN. FRAME W/ 6 MM FROSTED GLASS TOP HUNG WINDOW TO MANUF'S DTL.	POWDER COATED ALUMN. FRAME W/ 6 MM FROSTED GLASS TOP HUNG WINDOW TO MANUF'S DTL.	POWDER COATED ALUMN. FRAME W/ 6 MM FROSTED GLASS TOP HUNG WINDOW TO MANUF'S DTL.	POWDER COATED ALUMN. FRAME W/ 6 MM FIXED GLASS PANEL TO MANUF'S DTL.	POWDER COATED ALUMN. FRAME 6mm thk. TINTED FIXED GLASS PANEL TO MANUF'S DTL.
SIZE	HEIGHT	1100	2000	600	600	600	600	2250
	WIDTH	900	1000	900	1200	2400	4800	1000
LOCATION	ARAS 1 (BLOK UTAMA)	BILIK PENYELIA	BILIK KAWALAN	–	TANDAS LELAKI BILIK SEDIA WANITA	BILIK UTILITI PERALATAN BILIK SEDIA WANITA	–	RUANG LOBI
	ARAS 2 (BLOK UTAMA)	–	–	RUANG WUDUK	BILIK BASUH TANDAS LELAKI	–	BILIK SUKAN GYM	–
	ARAS (SETOR LOGISTIK)	–	–	–	–	SETOR LOGISTIK	–	–
	ARAS (RUMAH SAMPAH)	–	–	–	RUMAH SAMPAH	–	–	–
	ARAS (RUMAH PAM)	–	–	–	–	RUMAH PAM	–	–
FLOOR LEVELS	ARAS 1	1	1	–	2	2	–	2
	ARAS 2	–	–	2	4	–	1	–
	SETOR LOGISTIK	–	–	–	–	2	–	–
	RUMAH SAMPAH	–	–	–	2	–	–	–
TOTAL NOS		1	1	2	4	4	1	2

TYPE	W7
	
SPECIFICATION	POWDER COATED ALUMN. FRAME 6mm thk. TINTED FIXED GLASS PANEL TO MANUF'S DTL.
SIZE HEIGHT	12200
SIZE WIDTH	2700
LOCATION LOCATION ARAS 1 (BLOK UTAMA)	TANGGA 1
LOCATION LOCATION ARAS 2 (BLOK UTAMA)	–
FLOOR LEVELS ARAS 1	1
FLOOR LEVELS ARAS 2	–
TOTAL NOS	1

JADUAL TINGKAP

- BALAI BOMBA
- MENARA LATIHAN
- STOR LOGISTIK
- RUMAH SAMPAH
- RUMAH PAM

AS-BUILT DRAWING

Pemaju :

KEMENTERIAN PERUMAHAN DAN KERAJAAN TEMPATAN

Pemilik :

JABATAN BOMBA DAN PENYELAMAT MALAYSIA

Tajuk Projek:

CADANGAN PEMBINAAN PROJEK BALAI BOMBA & KUARTERS PUTATAN DI ATAS SEBAHAGIAN LOT N.T 213059771, JALAN SAILAN IMBAAN PUTATAN, DAERAH PUTATAN, SABAH

Tajuk Komponen:

(JADUAL TINGKAP)
BALAI BOMBA
MENARA LATIHAN
STOR LOGISTIK
RUMAH SAMPAH
RUMAH PAM

ALASIM OMAR ARCHITECT
F-27-1, ROYAL PLAZA PUTATAN
KM 11.2, JALAN PUTATAN
88200, KOTA KINABALU, SABAH
E : alasim.architect@gmail.com
T : +6 088 760 752
F: +6 088 761 752

DWG. INFO: Scale : As Shown; Date : JANUARY 2024; Drawing Number : Revision 0

DWG. TITLE: Sketch | DP Sub | JPBM | Construction; Prelim | BP Sub | Contract | As-Built

200413/ASBUILT/045/REV.0