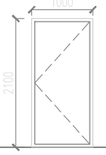
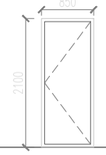
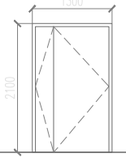
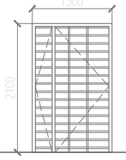
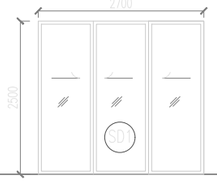
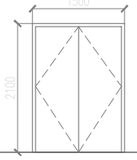
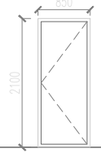
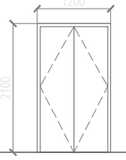
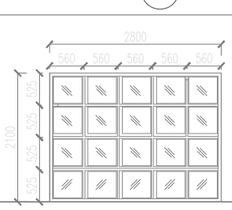
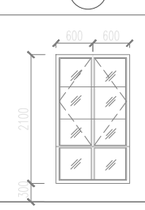
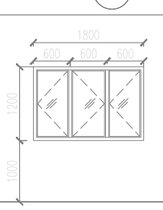
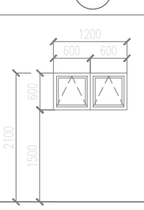
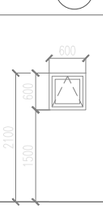
TYPE		D1	D2	D3	D4	SD1	FD1	FD2	FD3
									
SPECIFICATION		METAL FRAME TIMBER SOLID DOOR	METAL FRAME PLYWOOD FLUSH DOOR	METAL FRAME TIMBER SOLID DOOR	M.S GRILL DOOR	ALUMN FRAME GLASS SLIDING DOOR WITH FIXED GLASS PANEL.	1HR FIRE RATED DOOR	1HR FIRE RATED DOOR	1HR FIRE RATED DOOR
IRONMONGERY									
SIZE	HEIGHT	2100	2100	2100	2100	2100	2100	2100	2100
	WIDTH	1000	850	1300	1300	2700	1500	850	1200
LOCATION	ARAS BAWAH (KUARTERS E)	BILIK TIDUR UTAMA, BILIK TIDUR 2, BILIK TIDUR 3, BILIK TIDUR 4, DAPUR	BILIK AIR 1, BILIK AIR 2, BILIK AIR 3, TANDAS, UTILITI,	FOYER	UNIT KELAS E	BALKONI	–	–	–
	ARAS BAWAH (KUARTERS F)	BILIK TIDUR UTAMA, BILIK TIDUR 2, BILIK TIDUR 3, DAPUR,	BILIK AIR 1, BILIK AIR 2, TANDAS, UTILITI,	FOYER	UNIT KELAS F	BALKONI	–	–	–
	ARAS BAWAH (LOBI)	–	–	–	–	–	AIR, TELEFON, BILIK SERVIS	–	–
	ARAS SATU (KUARTERS F)	BILIK TIDUR UTAMA, BILIK TIDUR 2, BILIK TIDUR 3, DAPUR,	BILIK AIR 1, BILIK AIR 2, TANDAS, UTILITI,	FOYER	UNIT KELAS F	BALKONI	–	–	–
	ARAS SATU (LOBI)				–		AIR,	TELEFON	ELEK
FLOOR LEVELS	ARAS BAWAH (KUARTERS E)	6	5	2	1	1	–	–	–
	ARAS BAWAH (KUARTERS F)	5	4	2	1	1	–	–	–
	ARAS BAWAH (LOBI)	–	–	–	–	–	3	–	–
	ARAS SATU (KUARTERS F)	10	8	4	2	2	–	–	–
	ARAS SATU (LOBI)	–	–	–		–	1	1	1
REMARKS		METAL FRAME	METAL FRAME	METAL FRAME	M.S GRILL DOOR	METAL FRAME	FIRE RATED	FIRE RATED	FIRE RATED
TOTAL NOS		21	17	8	4	4	4	1	1

TYPE		W1	W2	W3	W4	W5
						
SPECIFICATION		POWDER COATED ALUMN. FRAME 6mm thk. GLASS PANEL WINDOW TO MANUF'S DTL.	POWDER COATED ALUMN. FRAME 6mm thk. TINTED GLASS CASEMENT WINDOW WITH BELLOW HUNG GLASS WINDOW ABOVE TO MANUF'S DTL.	POWDER COATED ALUMN. FRAME 6mm thk. TINTED GLASS CASEMENT WINDOW TO MANUF'S DTL.	POWDER COATED ALUMN. FRAME W/ 6 MM FROSTED GLASS TOP HUNG WINDOW TO MANUF'S DTL.	POWDER COATED ALUMN. FRAME W/ 6 MM FROSTED GLASS TOP HUNG WINDOW TO MANUF'S DTL.
IRONMONGERY						
SIZE	HEIGHT	2100	2100	1200	600	600
	WIDTH	2800	1200	1800	1200	600
LOCATION	ARAS BAWAH (KUARTERS E)	–	BILIK TIDUR UTAMA, BILIK TIDUR 2, BILIK TIDUR 3, BILIK TIDUR 4,	DAPUR	DAPUR	BILIK AIR 1, BILIK AIR 2, TANDAS
	ARAS BAWAH (KUARTERS F)	–	BILIK TIDUR UTAMA, BILIK TIDUR 2, BILIK TIDUR 3,	DAPUR	–	BILIK AIR 1, BILIK AIR 2, TANDAS
	ARAS BAWAH (LOBI)	–	–	–	–	–
	ARAS SATU (KUARTERS F)	–	BILIK TIDUR UTAMA, BILIK TIDUR 2, BILIK TIDUR 3,	DAPUR	–	BILIK AIR 1, BILIK AIR 2, TANDAS
	ARAS SATU (LOBI)	LOBI	–	–	–	–
FLOOR LEVELS	ARAS BAWAH (KUARTERS E)	–	5	1	2	4
	ARAS BAWAH (KUARTERS F)	–	4	1	–	3
	ARAS BAWAH (LOBI)	–	–	–	–	–
	ARAS SATU (KUARTERS F)	–	8	2	–	6
	ARAS SATU (LOBI)	1	–	–	–	–
REMARKS		POWDER COATED ALUMN. FRAME	POWDER COATED ALUMN. FRAME	POWDER COATED ALUMN. FRAME	POWDER COATED ALUMN. FRAME	POWDER COATED ALUMN. FRAME
TOTAL NOS		1	8	4	2	13

JADUAL PINTU & TINGKAP
KAURTERS

AS-BUILT DRAWING

Pemaju :

KEMENTERIAN PERUMAHAN DAN KERAJAAN TEMPATAN

Pemilik :

JABATAN BOMBA DAN PENYELAMAT MALAYSIA

Tajuk Projek:

CADANGAN PEMBINAAN PROJEK BALAI BOMBA & KUARTERS PUTATAN DI ATAS SEBAHAGIAN LOT N.T 213059771, JALAN SAILAN IMBAAN PUTATAN, DAERAH PUTATAN, SABAH

Tajuk Komponen:

(JADUAL PINTU & TINGKAP KUARTERS)

ALASM OMAR ARCHITECT
F-27-1, ROYAL PLAZA PUTATAN
KM 11.2, JALAN PUTATAN
88200, KOTA KINABALU, SABAH
E : alasim.architect@gmail.com
T : +6 088 760 752
F: +6 088 761 752

DWG INFO

Scale : As Shown
Date : JANUARY 2024

Drawing Number : Revision 0

DWG TITLE

Sketch	DP Sub	JPBM	Construction
Prelim	DP Sub	Contract	As-Built

200413/ASBUILT/046/REV.0