
ALASIM OMAR ARCHITECT
F-27-1, Royal Plaza Putatan,
Km 11.2, Jalan Putatan,
88200 Kota Kinabalu, Sabah.


PERUNDING IDEAL
No 13-3, Lot 9, 3rd Floor,
Block B, Damai Plaza 4,
88300 Kota Kinabalu, Sabah.

JURUTERA PERUNDING INTELEK SDN BHD
No 22-2, 2nd Floor, Block D, Lorong Plaza
Kingfisher 6, Plaza Kingfisher, Kuala Inanam
Likas, 88400 Kota Kinabalu, Sabah.


JURUKUR BAHAN KONSULTANT (SABAH)
3rd floor, Lot 8, Block A,
Damai Plaza Luyang,
88847 Kota Kinabalu, Sabah.


MTR ENGINEERING SDN. BHD.
1st Floor, Block C, Lot 23A,
Bundusan Commercial Centre,
Jalan Bundusan,
88300 Kota Kinabalu, Sabah.

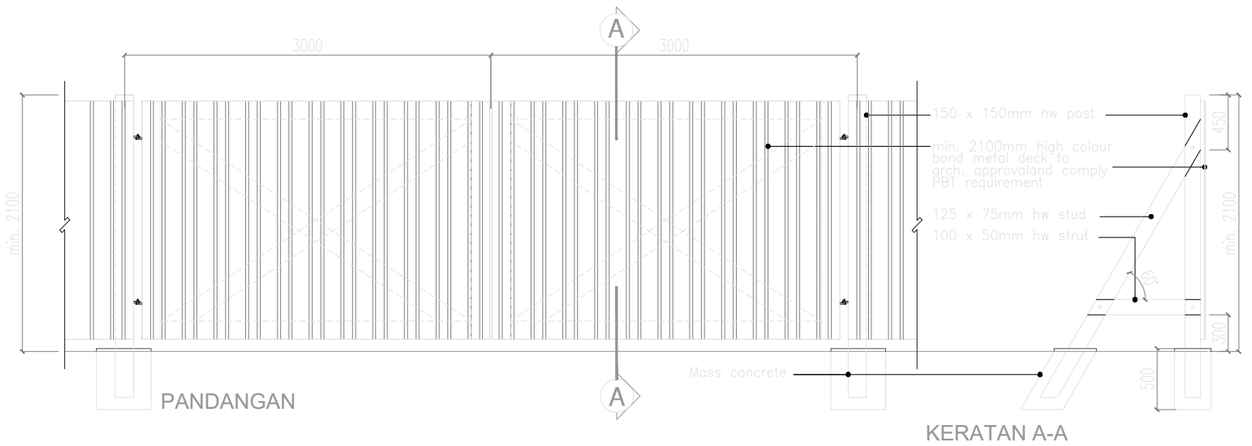

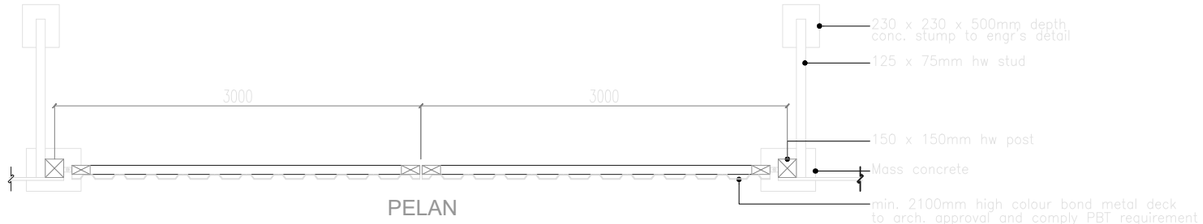

BUTIRAN HOARDING (GATE)

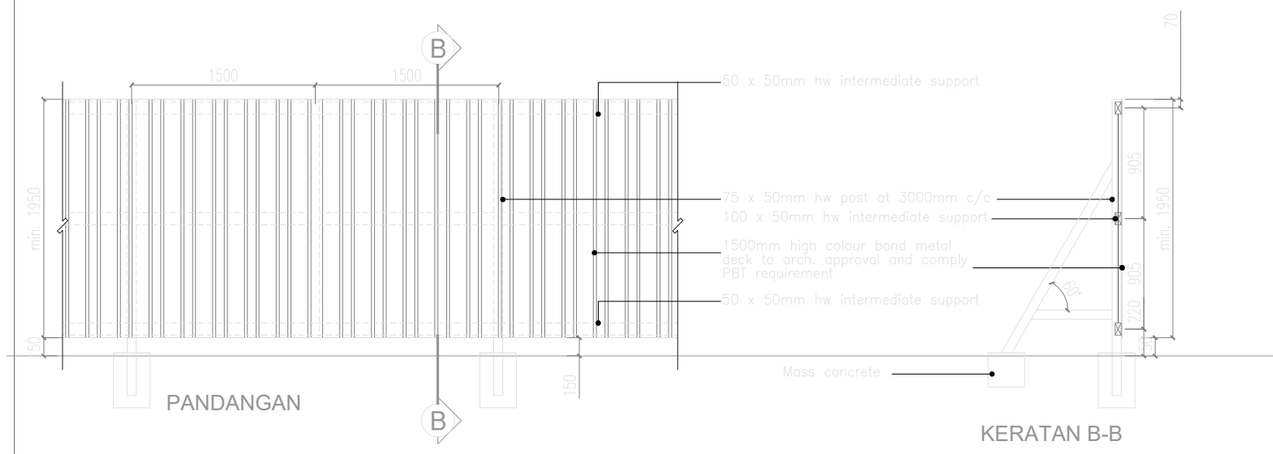

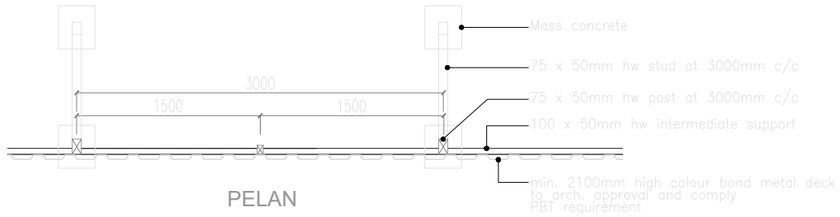

BUTIRAN HOARDING (TIPIKAL)

NOTA:-

LUKISAN INI MERUPAKAN LUKISAN PIAWAIAN YANG DI GUNAPAKAI OLEH KPKT, WALAUBAGAIMANAPUN KETINGGIAN HOARDING INI ADALAH TERTAKLUK KEPADA KEPERLUAN PIHAK BERKUASA TEMPATAN SESUATU PROJEK.

AS-BUILT DRAWING

Pemaju :
KEMENTERIAN PERUMAHAN DAN KERAJAAN TEMPATAN

Pemilik :
JABATAN BOMBA DAN PENYELAMAT MALAYSIA

Tajuk Projek:
CADANGAN PEMBINAAN PROJEK BALAI BOMBA & KUARTERS PUTATAN DI ATAS SEBAHAGIAN LOT N.T 213059771, JALAN SAILAN IMBAAN PUTATAN, DAERAH PUTATAN, SABAH

Tajuk Komponen:
LOGO DAN ALAMAT PAPAN TANDA HOARDING PIAWAI KPKT

Tajuk Lukisan:
LOGO DAN ALAMAT PAPAN TANDA
BUTIRAN HOARDING (GATE)
BUTIRAN HOARDING (TIPIKAL)

ALASIM OMAR ARCHITECT
F-27-1, ROYAL PLAZA PUTATAN
KM 11.2, JALAN PUTATAN
88200, KOTA KINABALU, SABAH
E : alasim.architect@gmail.com
T : +6 088 760 752
F: +6 088 761 752

Scale : As Shown
Date : JANUARY 2024

Sketch	DP Sub	JPBM	Construction
Prelim	BP Sub	Contract	As-Built

Drawing Number : Revision 0

DWG TITLE : 200413/ASBUILT/063/REV.0