
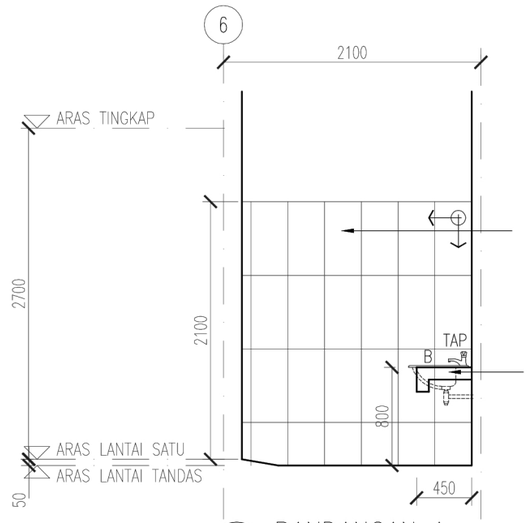


110mm THK. BWK WITH 20mm THK. CEMENT PLASTER C/W 300mm X 600mm CERAMIC WALL TILES UP TO 2100mm HIGHT

CONCRETE COUNTER TOP C/W 200mm X 200mm GLAZED CERAMIC TILES FINISHED


2 PANDANGAN A
SKALA 1:50

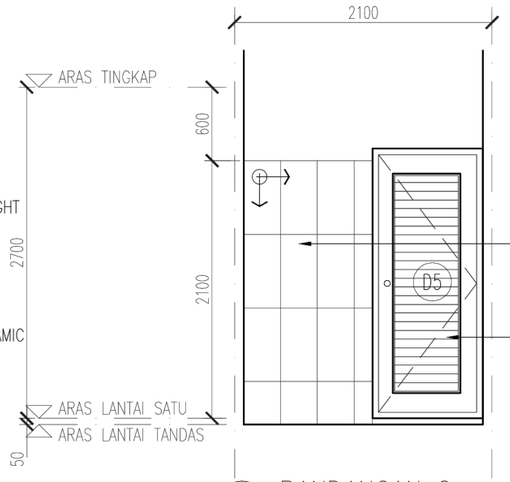

110mm THK. BWK WITH 20mm THK. CEMENT PLASTER C/W 300mm X 600mm CERAMIC WALL TILES UP TO 2100mm HIGHT

DOOR REFER TO DOOR SCHEDULE

4 PANDANGAN C
SKALA 1:50

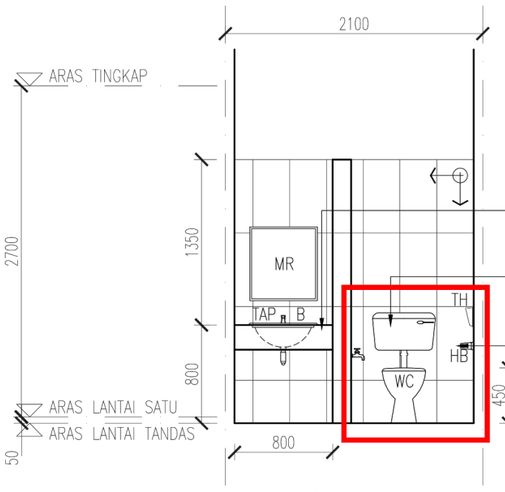


CONCRETE COUNTER TOP C/W 200mm X 200mm GLAZED CERAMIC TILES FINISHED

WATER CLOSET AND FLUSH VALVE WALL HUNG WASHDOWN WATER CLOSET

110mm THK. BWK WITH 20mm THK. CEMENT PLASTER C/W 300mm X 600mm CERAMIC WALL TILES UP TO 2100mm HIGHT

5 PANDANGAN D
SKALA 1:50

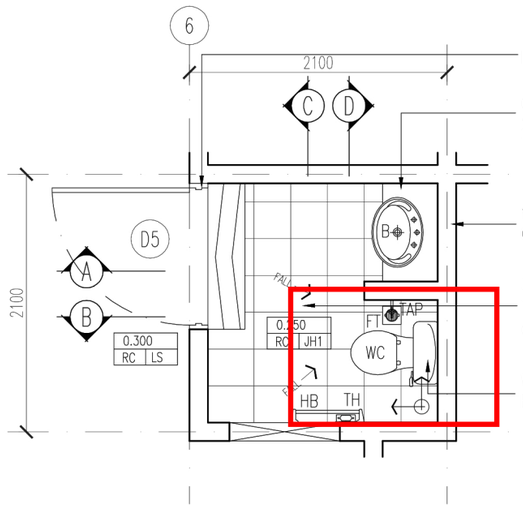

DOOR REFER TO DOOR SCHEDULE


CONCRETE COUNTER TOP C/W 200mm X 200mm GLAZED CERAMIC TILES FINISHED

115mm THK BRICKWALL WITH 20mm THK CEMENT PASTER ON BOTH SIDES

300mm x 300mm NON SLIP HOMO. TILES (INCLUSIVE CEMENT SCREEDING C/W WATER PROOFING)

WATER CLOSET AND FLUSH VALVE WALL HUNG WASHDOWN WATER CLOSET

1 PELAN LANTAI
SKALA 1:50

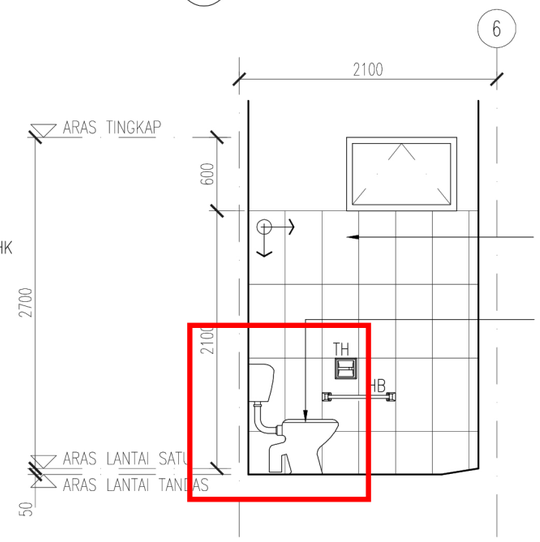

110mm THK. BWK WITH 20mm THK. CEMENT PLASTER C/W 300mm X 600mm CERAMIC WALL TILES UP TO 2100mm HIGHT

WATER CLOSET AND FLUSH VALVE WALL HUNG WASHDOWN WATER CLOSET

3 PANDANGAN B
SKALA 1:50

CONSTRUCTION DRAWING

Pemaju :

KEMENTERIAN PERUMAHAN DAN KERAJAAN TEMPATAN

Pemilik :

JABATAN BOMBA DAN PENYELAMAT MALAYSIA

Tajuk Projek:

CADANGAN PEMBINAAN PROJEK BALAI BOMBA & KUARTERS PUTATAN DI ATAS SEBAHAGIAN LOT N.T 213059771, JALAN SAILAN IMBAAN PUTATAN, DAERAH PUTATAN, SABAH

Tajuk Komponen:

BALAI BOMBA (TANDAS OKU)

Tajuk Lukisan:

PELAN LANTAI
PANDANGAN A
PANDANGAN B
PANDANGAN C
PANDANGAN D

ALASIM OMAR ARCHITECT
F-27-1, ROYAL PLAZA PUTATAN
KM 11.2, JALAN PUTATAN
88200, KOTA KINABALU, SABAH
E : alasim.architect@gmail.com
T : +6 088 760 752
F: +6 088 761 752

ARCHITECT

DWG INFO

Drawn by : SYAH
Checked by : Sym
Scale : As Shown
Date : JUN 2020

Drawing Number : Revision 0 1 2

DWG TITLE

Sketch	DP Sub	JPBM	Construction
Prelim	BP Sub	Contract	As-Built

200413/JBPMput/T0-13A