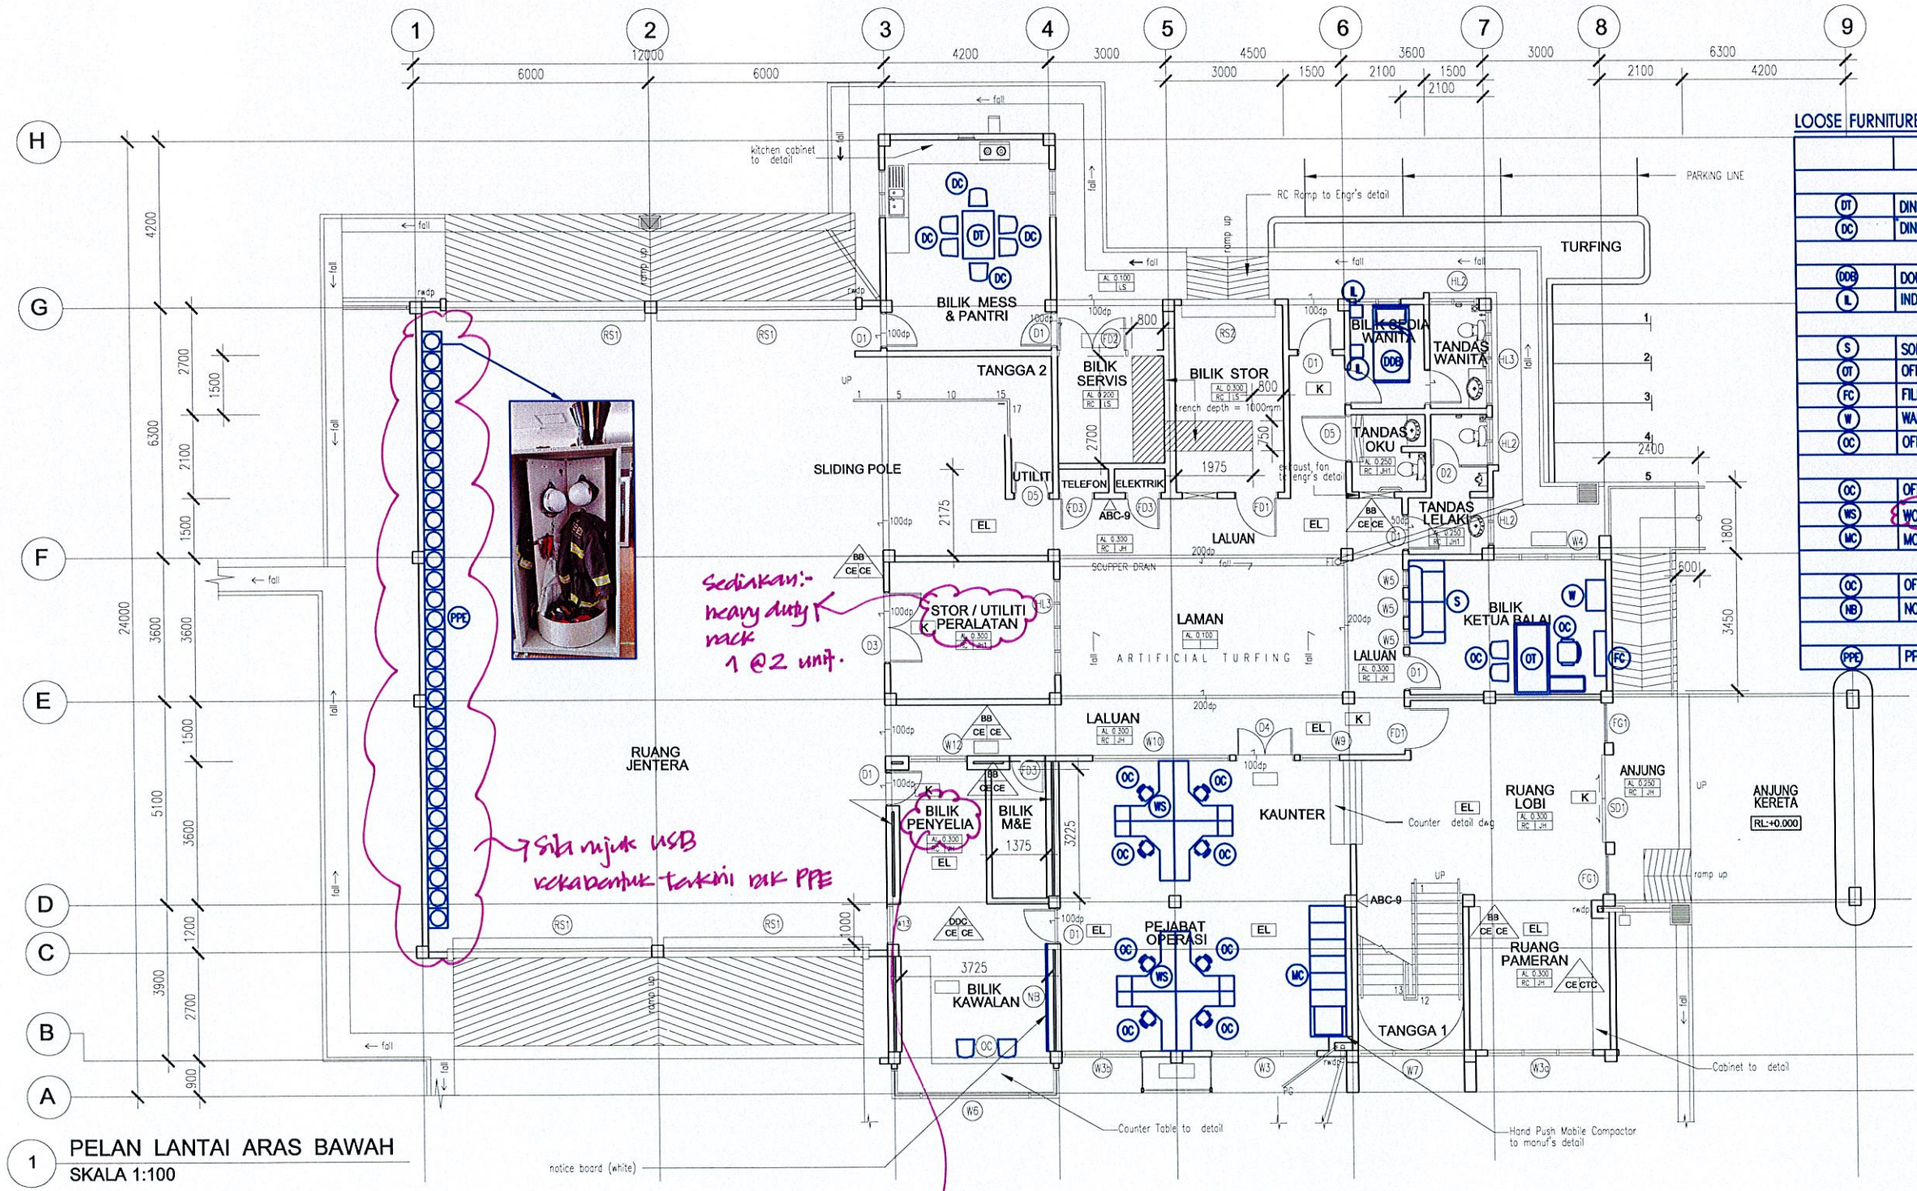


1 PELAN LANTAI ARAS BAWAH
SKALA 1:100

LOOSE FURNITURE SCHEDULE ARAS SATU Bawah.

	FURNITURE	SIZE (Wmm x Lmm)	NOS.
	BILIK MESS & PANTRI		
DT	DINING TABLE	800 X 1200	1
DC	DINING CHAIR	450 X 450	6
	BILIK PERSEDIAAN PENYELIA wanita		
DDB	DOUBLE DECKER SINGLE BED (METAL)	920 X 1955	1
IL	INDIVIDUAL LOCKER	320 X 320	2
	BILIK KETUA BALAI		
S	SOFA 2 SEATER	900 X 2000	1
OT	OFFICE TABLE	450 X 500	1
FC	FILE CABINET	300 X 1130	1
W	WARDROBE	500 X 780	1
OC	OFFICE CHAIR	450 X 500	3
	PEJABAT OPERASI		
OC	OFFICE CHAIR	450 X 500	8
WS	WORKSTATION	1500 X 1500	8
MC	MOBILE COMPACTER (HAND-PUSH)	915 X 3280 X 2115 (H)	1
	BILIK KAWALAN		
OC	OFFICE CHAIR	450 X 500	2
NB	NOTICE BOARD (WHITE)	50 X 2700	1
	RUANG JENTERA		
PPE	PPE STORAGE	500 X 500 X 1350 (H)	30

*workstation adakah bersekali dengan mobile pedestal??

Sila semak kekalbentuk PPE Terkini.

Ar. Ts. AZRI BIN AJI
Penguasa Bomba
Bahagian Pembangunan
Jabatan Bomba dan Penyelamat Malaysia
22.04.2022

Pemaju : KEMENTERIAN PERUMAHAN DAN KERAJAAN TEMPATAN

Pemilik : JABATAN BOMBA DAN PENYELAMAT MALAYSIA

Tajuk Projek:
CADANGAN PEMBINAAN PROJEK BALAI BOMBA & KUARTERS PUTATAN DI ATAS SEBAHAGIAN LOT N.T 213059771, JALAN SAILAN IMBAAN PUTATAN, DAERAH PUTATAN, SABAH


Tajuk Komponen: Balai Bomba Putatan

Tajuk Lukisan: Loose Furniture layout Aras Bawah

ARCHITECT
ALASIM OMAR ARCHITECT
F-27-1, ROYAL PLAZA PUTATAN
KM 11.2, JALAN PUTATAN
88200, KOTA KINABALU, SABAH
E : alasim.architect@gmail.com
T : +6 088 760 752
F: +6 088 761 752

DWG INFO
Drawn by : DANIAL
Checked by : Sym
Scale : As Shown
Date : APR 2022
Drawing Number : Revision 0 1 2

DWG TITLE
Sketch | DP Sub | JPBM | Construction
Prelim | BP Sub | Contract | As-Built

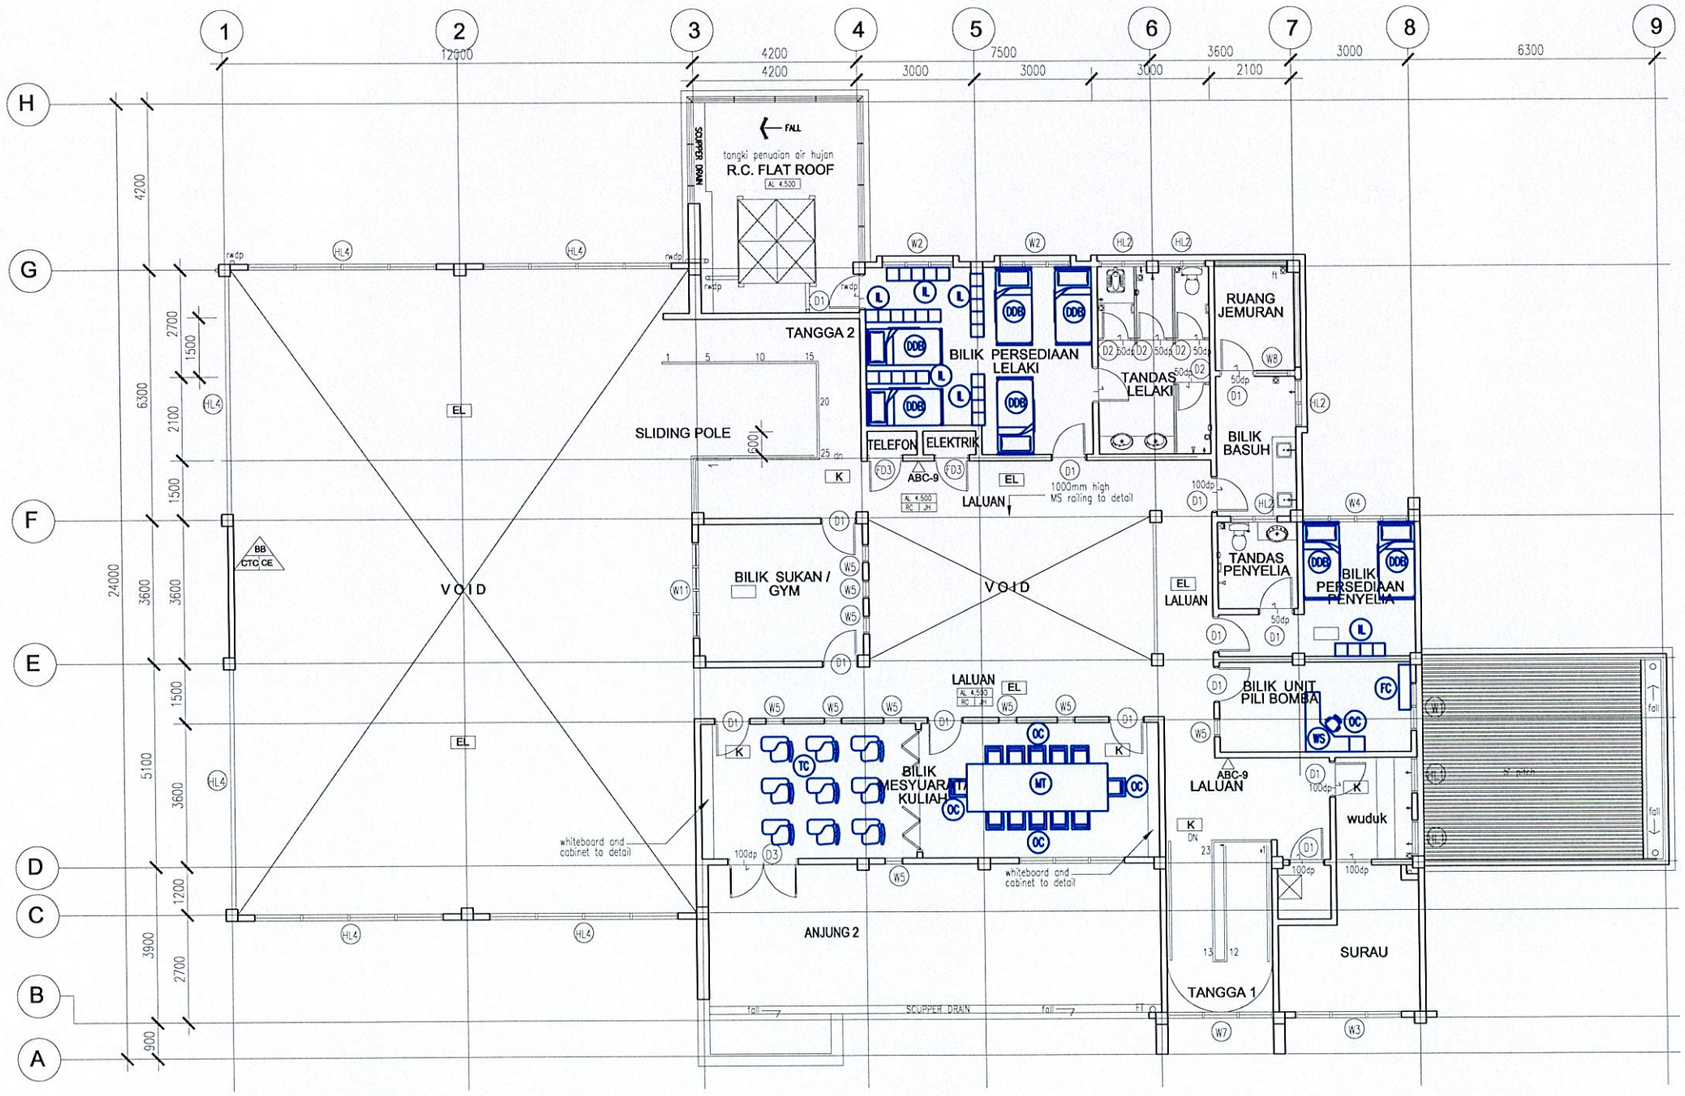

2 PELAN LANTAI ARAS SATU
SKALA 1:100

LOOSE FURNITURE SCHEDULE ARAS SATU

	FURNITURE	SIZE (Wmm x Lmm)	NOS.
	BILIK PERSEDIAAN LELAKI		
DDB	DOUBLE DECKER SINGLE BED (METAL)	920 X 1955	5
L	INDIVIDUAL LOCKER	320 X 320	25
	BILIK PERSEDIAAN PENYELIA		
DDB	DOUBLE DECKER SINGLE BED	920 X 1955	2
L	INDIVIDUAL LOCKER	320 X 320	4
	BILIK UNIT PILI BOMBA		
WS	WORKSTATION	1500 X 1500	1
OC	OFFICE CHAIR	450 X 500	1
FC	FILE CABINET	300 X 1130	1
	BILIK MESYUARAT/KULIAH		
MT	MEETING TABLE	1200 X 3600	1
OC	OFFICE CHAIR	450 X 500	12
TC	TRAINING CHAIR	440 X 450	9

Ar. Ts. AZRI BIN AJI
Penguasa Bomba
Bahagian Pembangunan
Jabatan Bomba dan Penyelamat Malaysia
22.04.2022

Pemaju :
KEMENTERIAN PERUMAHAN DAN KERAJAAN TEMPATAN

Pemilik :
JABATAN BOMBA DAN PENYELAMAT MALAYSIA

Tajuk Projek:
CADANGAN PEMBINAAN PROJEK BALAI BOMBA & KUARTERS PUTATAN DI ATAS SEBAHAGIAN LOT N.T 213059771, JALAN SAILAN IMBAAN PUTATAN, DAERAH PUTATAN, SABAH

Tajuk Komponen:
Balai Bomba Putatan

Tajuk Lukisan:
Loose Furniture layout
Aras Satu

ARCHITECT
ALASIM OMAR ARCHITECT
F-27-1, ROYAL PLAZA PUTATAN
KM 11.2, JALAN PUTATAN
88200, KOTA KINABALU, SABAH
E : alasim.architect@gmail.com
T : +6 088 760 752
F: +6 088 761 752

DWG INFO
Drawn by : DANIAL
Checked by : Sym
Scale : As Shown
Date : APR 2022
Drawing Number : Revision 0 1 2

DWG TITLE

Sketch	DP Sub	JPBM	Construction
Prelim	BP Sub	Contract	As-Built